USE TYPEWRITER OR BALL POINT PEN-PRESS FIRMLY, PRINT CLEARLY.

WATER WELL RECORD
KSA 82a-1201-1215

Kansas Department of Health and Environment-Division of Environment
(Water well Contractors)
Topeka, Kansas 66620

1. Location of well:	County	Fraction	Section number	Township number	Range number
	Scott	SE 1/4 SE 1/4 SE 1/4	16	T 18 S	R 34 E (W)

2. Distance and direction from nearest town or city: In Modoc, Kansas

Street address of well location if in city:

3. Owner of well: C. G. Sharpe
R.R. or street: RFD #1 - Box 1
City, state, zip code: Modoc, KS 67866

4. Locate with "X" in section below:

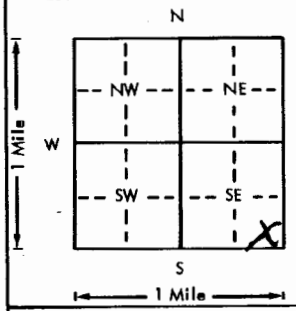

Sketch map:

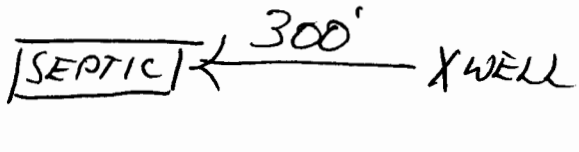

6. Bore hole dia. 9 in. Completion date
Well depth 135 ft. 5-6-77

7. __ Cable tool X Rotary __ Driven __ Dug
__ Hollow rod __ Jetted __ Bored __ Reverse rotary

8. Use: X Domestic __ Public supply __ Industry
__ Irrigation __ Air conditioning __ Stock
__ Lawn __ Oil field water __ Other

9. Casing: Material Plas. Height: Above or below
Threaded ___ Welded Glue Surface 12 in.
RMP X PVC ___ Weight 1.8 lbs./ft.
Dia. 5 in. to 115 ft. depth Wall Thickness: inches or
Dia. ___ in. to ___ ft. depth gage No. .250

10. Screen: Manufacturer's name
Jess & Lowell
Type RMP Dia. 5 in.
Slot/gauze 1/16 Length 20 ft.
Set between 115 ft. and 135 ft.
___ ft. and ___ ft.
Gravel pack? yes Size range of material 1/4-1/8

11. Static water level: mo./day/yr.
105 ft. below land surface Date 5-2-77

12. Pumping level below land surfaces:
115 ft. after 1 hrs. pumping 4 g.p.m.
___ ft. after ___ hrs. pumping ___ g.p.m.
Estimated maximum yield 4 g.p.m.

13. Water sample submitted: mo./day/yr.
__ Yes X No Date

14. Well head completion:
__ Pitless adapter 12 Inches above grade

15. Well grouted? yes
With: X Neat cement ___ Bentonite ___ Concrete
Depth: From 0 ft. to 15 ft.

16. Nearest source of possible contamination:
ft. 300 Direction West Type Septic
Well disinfected upon completion? X Yes ___ No

17. Pump: ___ Not installed
Manufacturer's name Aermotor
Model number ___ HP ___ Volts ___
Length of drop pipe 134 ft. capacity 4 g.p.m.
Type:
__ Submersible __ Turbine
__ Jet __ Reciprocating
__ Centrifugal Windmill X Other

5. Type and color of material	From	To
Clay	0	30
Gyp	30	40
Fine sd	40	45
Sd coarse	45	97
Sd rock	97	99
Sd coarse	99	110
Fine sd clay	110	117
Fine sd T	117	129
Sd coarse	129	131
Clay yellow	131	138
Shale	138	

(Use a second sheet if needed)

18. Elevation:

Topography:
__ Hill
__ Slope
X Upland
__ Valley

19. Remarks:

20. Water well contractor's certification:
This well was drilled under my jurisdiction and this report is true to the best of my knowledge and belief.
Business name Weishaar Drilling License No. 232
Address Scott City, KS 67871
Signed [signature] Date
Authorized representative 6-7-77

T 18 R 34 E (W) Sec 16 SESESE 1/4 1/4 1/4

Forward the white, blue and pink copies to the Department of Health and Environment

Form WWC-5

MI-1023