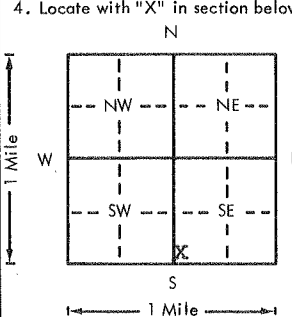


USE TYPEWRITER OR BALL POINT PEN-PRESS FIRMLY, PRINT CLEARLY.

WATER WELL RECORD
KSA 82a-1201-1215

Kansas Department of Health and Environment-Division of Environment (Water well Contractors) Topeka, Kansas 66620

1. Location of well:	County Scott	Fraction SW 1/4 SW 1/4 SE 1/4	Section number 22	Township number T 18 S	Range number R 34 E/W
2. Distance and direction from nearest town or city: 6W, 1S, 2 3/4W of Scott City, KS			3. Owner of well: Albert Hoeme R.R. or street: 803 Russell City, state, zip code: Scott City, KS 67871		
4. Locate with "X" in section below: 			Sketch map: Septic 1/2 mi. X well		
5. Type and color of material			From	To	6. Bore hole dia. 18 in. Completion date Well depth 128 ft. 2-20-76
Clay			0	16	7. <input type="checkbox"/> Cable tool <input type="checkbox"/> Rotary <input type="checkbox"/> Driven <input type="checkbox"/> Dug <input type="checkbox"/> Hollow rod <input type="checkbox"/> Jetted <input type="checkbox"/> Bored <input checked="" type="checkbox"/> Reverse rotary
Gyp			16	30	8. Use: <input type="checkbox"/> Domestic <input type="checkbox"/> Public supply <input type="checkbox"/> Industry <input checked="" type="checkbox"/> Irrigation <input type="checkbox"/> Air conditioning <input type="checkbox"/> Stock <input type="checkbox"/> Lawn <input type="checkbox"/> Oil field water <input type="checkbox"/> Other
Gyp			30	34	9. Casing: Material Plas Height: Above or below Threaded <input type="checkbox"/> Welded Glue Surface 12 in. RMP <input checked="" type="checkbox"/> PVC <input type="checkbox"/> Weight 3 lbs./ft. Dia. 8 in. to 128 ft. depth Wall Thickness: inches or Dia. <input type="checkbox"/> in. to <input type="checkbox"/> ft. depth Gauge No. 250
Sd med			34	38	10. Screen: Manufacturer's name Jess & Lowell Type RMP Dia. 8 in. Slot/gauze 1/8 Length 30 ft. Set between 98 ft. and 128 ft. <input type="checkbox"/> ft. and <input type="checkbox"/> ft. Gravel pack? yes Size range of material 1/2 - 1/4
Sd rock			38	41	11. Static water level: NA mo./day/yr. <input type="checkbox"/> ft. below land surface Date <input type="checkbox"/>
Fine sd clay			41	63	12. Pumping level below land surfaces: NA <input type="checkbox"/> ft. after <input type="checkbox"/> hrs. pumping <input type="checkbox"/> g.p.m. <input type="checkbox"/> ft. after <input type="checkbox"/> hrs. pumping <input type="checkbox"/> g.p.m. Estimated maximum yield <input type="checkbox"/> g.p.m.
Sd coarse			63	125	13. Water sample submitted: <input type="checkbox"/> Yes <input checked="" type="checkbox"/> No Date <input type="checkbox"/>
Clay yellow			125	135	14. Well head completion: <input type="checkbox"/> Pitless adapter 12 Inches above grade
Shale			135		15. Well grouted? <input type="checkbox"/> With: <input checked="" type="checkbox"/> Neat cement <input type="checkbox"/> Bentonite <input type="checkbox"/> Concrete Depth: From 0 ft. to 10 ft.
(Use a second sheet if needed)					16. Nearest source of possible contamination: ft. 2640 Direction N Type Septic Well disinfected upon completion? <input checked="" type="checkbox"/> Yes <input type="checkbox"/> No
					17. Pump: <input type="checkbox"/> Not installed Manufacturer's name Goulds Model number JH66MC34 HP 15 Volts 460 Length of drop pipe 120 ft. capacity NA g.p.m. Type: <input checked="" type="checkbox"/> Submersible <input type="checkbox"/> Turbine <input type="checkbox"/> Jet <input type="checkbox"/> Reciprocating <input type="checkbox"/> Centrifugal <input type="checkbox"/> Other
18. Elevation: Topography: <input type="checkbox"/> Hill <input checked="" type="checkbox"/> Slope <input type="checkbox"/> Upland <input type="checkbox"/> Valley	19. Remarks:		20. Water well contractor's certification: This well was drilled under my jurisdiction and this report is true to the best of my knowledge and belief. Weishaar Drilling 232 Business name License No. Address Scott City, KS 67871 Signed <i>[Signature]</i> Date 7-21-76 Authorized Representative		

T
1
8
3
1
W
m
a
a
e
1/4
1/4
1/4

Forward the white, blue and pink copies to the Department of Health and Environment

Form WWC-5