

USE TYPEWRITER OR BALL POINT PEN-PRESS FIRMLY, PRINT CLEARLY.

MUSOC

1834W31B
T R EW sec 1/4 1/4 1/4 No.


WATER WELL RECORD
KSA 82a-1201-1215

Kansas State Dept. Of Health
(Water Well Contractors)
Forbes-Bldg. 740
Topeka, Kansas 66620

BBD

1 Location of well: County Scott Township name Isabel NW Fraction QNW 1/4 Section number 31 Town number T 18 S Range number R 34 W

Distance and direction from nearest town or city: 9W, 2S, 1 1/2 W of Scott City, Kansas
3 Owner of well: W. N. Robinson
Address: Scott City, Kansas 67871

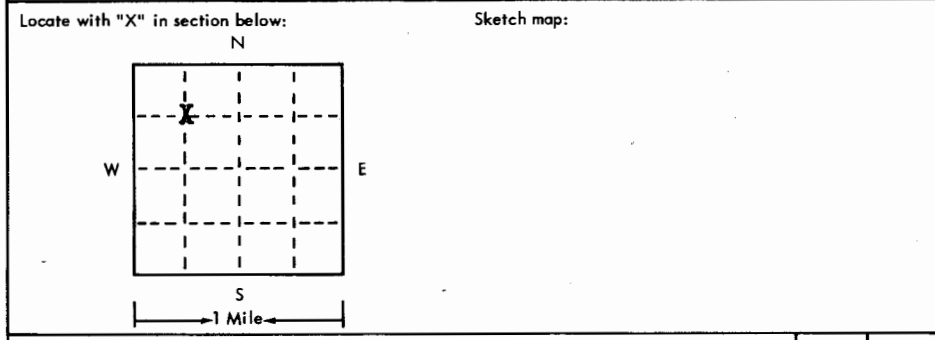

4 Well depth: 140 ft. Date of completion 3-5-75
Well diameter 9 in.
5 Cable tool Rotary Driven Dug
 Hollow rod Jetted Bored Reverse rotary
6 Use: Domestic Public supply Industry
 Irrigation Air conditioning Commercial
 Test well Observation Well
7 Casing: Material Plastic above below
Threaded Welded Surface 12 in.
Diam. 5 in. to 140 ft. depth Drive shoe? Yes No
Weight 1 1/2 lbs./ft.

| 2 | Type and color of material | From | To |
|---|--------------------------------|------|-----|
| | Clay | 0 | 22 |
| | Gyp | 22 | 46 |
| | Clay | 46 | 51 |
| | Sand | 51 | 60 |
| | Sandy Clay-tight | 60 | 72 |
| | Medium sand to gravel | 72 | 115 |
| | Rock | 115 | 118 |
| | Sand and Gravel | 118 | 136 |
| | Yellow | 136 | 137 |
| | Shale | 137 | 140 |
| | <u>BROCK 136'</u> | | |
| | (use a second sheet if needed) | | |

8 Screen:
Manufacturer J & L Plastic
Type Plastic PVC Dia. 5"
Slot gauge 1/8" Length 20'
Set between 120 ft. and 140 ft.
Fittings:
Gravel pack Yes No Size range of material 1/2
9 Static water level:
100 ft. below land surface Date 3-5-75
10 Pumping level below land surfaces:
____ ft. after ____ hrs. pumping ____ g.p.m.
____ ft. after ____ hrs. pumping ____ g.p.m.
Estimated maximum yield 50 g.p.m.
11 Water sample submitted:
 Yes No Date ____
12 Well head completion: 12
 Pitless adapter Inches above grade
13 Well grouted? Yes No
 Neat cement Bentonite _____
Depth: From 20 ft. to 20 ft.
14 Nearest source of possible contamination: Feed Lot
ft. 1300 Direction SE Type Lot
Well disinfected upon completion? Yes No
15 Pump: Not installed
Manufacturer's name _____
Model number _____ HP _____ Volts _____
Length of drop pipe _____ ft. capacity _____ g.m.p.
Type:
 Submersible Turbine
 Jet Reciprocating
 Centrifugal Other

16 Remarks: elevation 3156 (TOPO)
Topography:
 Hill Slope Upland Valley
Flat

17 Water well contractor's certification:
This well was drilled under my jurisdiction and this report is true to the best of my knowledge and belief.
ABC Drilling Co. 246
Business name License No.
Address Scott City, Kansas
Signed Dell Nottingham
Authorized representative 3-12-75