


1 LOCATION OF WATER WELL: Fraction NE 1/4 SE 1/4 NE 1/4 Section Number 28 Township Number T 18 S Range Number R 34 (E/W)
 County: Scott

Distance and direction from nearest town or city street address of well if located within city?

2 WATER WELL OWNER: Kennedy Farms
 RR#, St. Address, Box #: Rt. #1, Box 83 Board of Agriculture, Division of Water Resources
 City, State, ZIP Code: Modoc, Ks. 67863 Application Number:

3 LOCATE WELL'S LOCATION WITH AN "X" IN SECTION BOX:

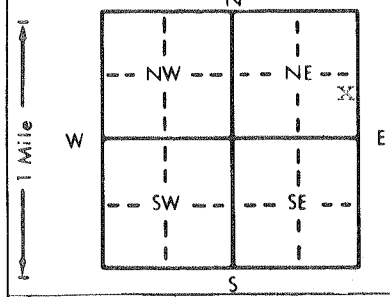

4 DEPTH OF COMPLETED WELL... 176 ft. ELEVATION: ...
 Depth(s) Groundwater Encountered 1. ft. 2. ft. 3. ft.
 WELL'S STATIC WATER LEVEL ... 131 ... ft. below land surface measured on mo/day/yr 3-3-95
 Pump test data: Well water was ft. after hours pumping gpm
 Est. Yield ... 25 ... gpm: Well water was ft. after hours pumping gpm
 Bore Hole Diameter ... 10 ... in. to ... 176 ... ft., and ... in. to ... ft.
 WELL WATER TO BE USED AS: 5 Public water supply 8 Air conditioning 11 Injection well
 Domestic 3 Feedlot 6 Oil field water supply 9 Dewatering 12 Other (Specify below)
 2 Irrigation 4 Industrial 7 Lawn and garden only 10 Monitoring well
 Was a chemical/bacteriological sample submitted to Department? Yes.....No...; If yes, mo/day/yr sample was submitted
 Water Well Disinfected? Yes No

5 TYPE OF BLANK CASING USED: 5 Wrought iron 8 Concrete tile CASING JOINTS: Glued Clamped
 1 Steel 3 RMP (SR) 6 Asbestos-Cement 9 Other (specify below) Welded
 PVC 4 ABS 7 Fiberglass Threaded
 Blank casing diameter ... 5 ... in. to ... 176 ... ft., Dia ... in. to ... ft., Dia ... in. to ... ft.
 Casing height above land surface ... 12 ... in., weight ... lbs./ft. Wall thickness or gauge No. 200 psi

TYPE OF SCREEN OR PERFORATION MATERIAL: PVC 10 Asbestos-cement
 1 Steel 3 Stainless steel 5 Fiberglass 8 RMP (SR) 11 Other (specify)
 2 Brass 4 Galvanized steel 6 Concrete tile 9 ABS 12 None used (open hole)
 SCREEN OR PERFORATION OPENINGS ARE: 5 Gauzed wrapped Saw cut 11 None (open hole)
 1 Continuous slot 3 Mill slot 6 Wire wrapped 9 Drilled holes
 2 Louvered shutter 4 Key punched 7 Torch cut 10 Other (specify)
 SCREEN-PERFORATED INTERVALS: From ... 151 ... ft. to ... 176 ... ft., From ... ft. to ... ft.
 GRAVEL PACK INTERVALS: From ... 25 ... ft. to ... 176 ... ft., From ... ft. to ... ft.

6 GROUT MATERIAL: 1 Neat cement 2 Cement grout Bentonite 4 Other
 Grout Intervals: From ... 5 ... ft. to ... 25 ... ft., From ... ft. to ... ft., From ... ft. to ... ft.
 What is the nearest source of possible contamination: 10 Livestock pens 14 Abandoned water well
 Septic tank 4 Lateral lines 7 Pit privy 11 Fuel storage 15 Oil well/Gas well
 2 Sewer lines 5 Cess pool 8 Sewage lagoon 12 Fertilizer storage 16 Other (specify below)
 3 Watertight sewer lines 6 Seepage pit 9 Feedyard 13 Insecticide storage
 Direction from well? How many feet? 100

FROM	TO	LITHOLOGIC LOG	FROM	TO	PLUGGING INTERVALS
0	1	top soil			
1	41	brown clay & gypsum			
41	51	coarse sand & gravel			
51	81	brown clay & gypsum			
81	90	fine sand with clay streaks			
90	102	brown clay			
102	155	fine sand with clay streaks			
155	175	fine to medium & coarse sand			
175	176	brown clay			

7 CONTRACTOR'S OR LANDOWNER'S CERTIFICATION: This water well was (1) constructed, (2) reconstructed, or (3) plugged under my jurisdiction and was completed on (mo/day/year) 2-7-95 and this record is true to the best of my knowledge and belief. Kansas Water Well Contractor's License No. 532 This Water Well Record was completed on (mo/day/yr) 3-3-95 under the business name of Midwest Well & Pump by (signature) *Victor Sankup*