


**1 LOCATION OF WATER WELL:**  
 County: WICHITA Fraction NE 1/4 Section Number 7 Township Number 18 Range Number 35  
 Distance and direction from nearest town or city street address of well if located within city?

**2 WATER WELL OWNER:** JO. ZELNER JR Global Positioning Systems (decimal degrees, min. of 4 digits)  
 Latitude: \_\_\_\_\_  
 Longitude: \_\_\_\_\_  
 Elevation: \_\_\_\_\_  
 City, State ZIP Code: LEOTI KS 67861 Datum: \_\_\_\_\_  
 Data Collection Method: \_\_\_\_\_

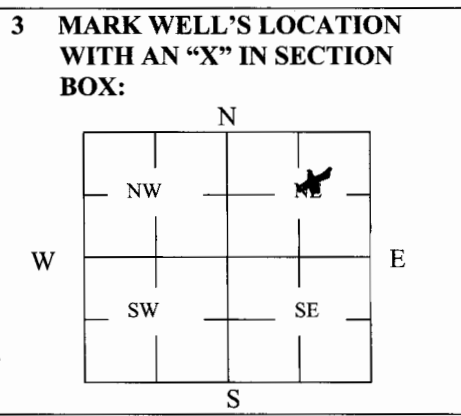

**4 DEPTH OF WELL** 170 ft.  
 WELL'S STATIC WATER LEVEL 0 ft.  
 WELL WAS USED AS:  
 1 Domestic  5 Public Water Supply  9 Dewatering   
 Irrigation  6 Oil Field Water Supply  10 Monitoring   
 3 Feedlot  7 Domestic (Lawn & Garden)  11 Injection Well   
 4 Industrial  8 Air Conditioning  12 Other \_\_\_\_\_  
 Was a chemical/bacteriological sample submitted to Department? Yes \_\_\_\_\_ No

**5 TYPE OF BLANK CASING USED:**  
 Steel  3 RMP (SR)  5 Wrought  7 Fiberglass  9 Other (Specify below) \_\_\_\_\_  
 2 PVC  4 ABS  6 Asbestos-Cement  8 Concrete Tile \_\_\_\_\_  
 Blank casing diameter 14 in. Was casing pulled? Yes  No \_\_\_\_\_ If yes, how much 4 F  
 Casing height above or below land surface 36 in.

**6 GROUT PLUG MATERIAL:** 1 Neat cement 2 Cement grout 3 Bentonite 4 Other \_\_\_\_\_  
 Grout Plug Intervals: From 170 ft. to 0 ft., From 0 ft. to 4 ft., From 4 to 0 ft.  
 What is the nearest source of possible contamination:  
 1 Septic tank 6 Seepage pit 11 Fuel Storage 16 Other (specify below) \_\_\_\_\_  
 2 Sewer lines 7 Pit privy 12 Fertilizer storage \_\_\_\_\_  
 3 Watertight sewer lines 8 Sewage lagoon 13 Insecticide storage \_\_\_\_\_  
 4 Lateral lines 9 Feedyard  14 Abandoned water well Direction from well? NW  
 5 Cess pool 10 Livestock pens 15 Oil well/Gas well How many feet? 1800

FROM	TO	PLUGGING MATERIALS	FROM	TO	PLUGGING MATERIALS
170	0	Sand			
0	4	Bentonite			
4	0	Dirt			

**7 CONTRACTOR'S OR LANDOWNER'S CERTIFICATION:** This water well was plugged under my jurisdiction and was completed on (mo/day/year) 11-19-07 and this record is true to the best of my knowledge and belief. Kansas Water Well Contractor's License No. \_\_\_\_\_ This Water Well Record was completed on (mo/day/year) 11-19-07 under the business name of Dones Crutain by (signature) Neil Stensen

**INSTRUCTIONS:** Use typewriter or ballpoint pen. Please press firmly and print clearly. Please fill in blanks, underline or circle the correct answers. Send top three copies to Kansas Department of Health and Environment, Bureau of Water, Geology Section, 1000 SW Jackson St., Ste. 420, Topeka, Kansas 66612-1367. Telephone: 785/296-5522. Send one to Water Well Owner and retain one for your records. Visit us at <http://www.kdheks.gov/geo/waterwells>.