

CORRECTION(S) TO WATER WELL RECORD (WWC-5)
(to rectify lacking or incorrect information)

County: Wichita

Location listed as:

Location changed to:

Section-Township-Range: 7-185-35W

7-185-35W

Fraction ($\frac{1}{4}$ $\frac{1}{4}$ $\frac{1}{4}$): SE

W2 NW SE

Other changes: Initial statements: _____

Changed to: _____

Comments: _____


verification method: County ownership directory, KGS' "WIMAS" & "WIZARD" database records for this well, and mapping tool & aerial photos on KGS website. initials: ARL date: 9/25/2008

WATER WELL PLUGGING RECORD Form WWC-5P KSA 82a-1212 ID NO.

1 LOCATION OF WATER WELL: County: <u>WICHITA</u>	Fraction <u>SE</u> 1/4 1/4 1/4	Section Number <u>7</u>	Township Number <u>18S</u>	Range Number <u>35</u> P/W
--	--------------------------------	-------------------------	----------------------------	----------------------------

Distance and direction from nearest town or city street address of well if located within city?

2 WATER WELL OWNER: <u>Jo Zebner JR</u> RR#, St. Address, Box #: City, State ZIP Code: <u>LEOTI KS 67861</u>	Global Positioning Systems (decimal degrees, min. of 4 digits) Latitude: _____ Longitude: _____ Elevation: _____ Datum: _____ Data Collection Method: _____
---	---

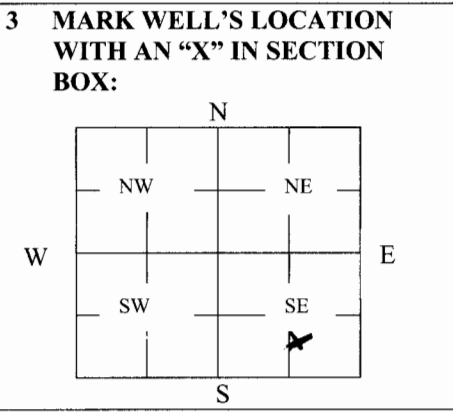

4 DEPTH OF WELL 171 ft.
WELL'S STATIC WATER LEVEL 24' ft.
WELL WAS USED AS:

1 Domestic	5 Public Water Supply	9 Dewatering
<input checked="" type="checkbox"/> 2 Irrigation	6 Oil Field Water Supply	10 Monitoring
3 Feedlot	7 Domestic (Lawn & Garden)	11 Injection Well
4 Industrial	8 Air Conditioning	12 Other _____

Was a chemical/bacteriological sample submitted to Department? Yes _____ No

5 TYPE OF BLANK CASING USED:

1 Steel	3 RMP (SR)	5 Wrought	7 Fiberglass	9 Other (Specify below) _____
2 PVC	4 ABS	6 Asbestos-Cement	8 Concrete Tile	

Blank casing diameter 16 in. Was casing pulled? Yes No _____ If yes, how much 4'
 Casing height above or below land surface 40 in.

6 GROUT PLUG MATERIAL: 1 Neat cement 2 Cement grout 3 Bentonite 4 Other _____

Grout Plug Intervals: From 171 ft. to 30 ft., From 30 ft. to 7 ft., From 7 to 4 ft.

What is the nearest source of possible contamination:

1 Septic tank	6 Seepage pit	11 Fuel Storage	16 Other (specify below) <u>NONE</u>
2 Sewer lines	7 Pit privy	12 Fertilizer storage	
3 Watertight sewer lines	8 Sewage lagoon	13 Insecticide storage	
4 Lateral lines	9 Feedyard	14 Abandoned water well	Direction from well? _____
5 Cess pool	10 Livestock pens	15 Oil well/Gas well	How many feet? _____

FROM	TO	PLUGGING MATERIALS	FROM	TO	PLUGGING MATERIALS
<u>171</u>	<u>30</u>	<u>Sand</u>			
<u>30</u>	<u>7</u>	<u>and</u>			
<u>7</u>	<u>4</u>	<u>Bentonite</u>			
<u>4</u>	<u>0</u>	<u>and</u>			

7 CONTRACTOR'S OR LANDOWNER'S CERTIFICATION: This water well was plugged under my jurisdiction and was completed on (mo/day/year) 8-12-08 and this record is true to the best of my knowledge and belief. Kansas Water Well Contractor's License No. _____. This Water Well Record was completed on (mo/day/year) 8-12-08 under the business name of Tony Crutacum by (signature) Cliff Stense

INSTRUCTIONS: Use typewriter or ballpoint pen. Please press firmly and print clearly. Please fill in blanks, underline or circle the correct answers. Send top three copies to Kansas Department of Health and Environment, Bureau of Water, Geology Section, 1000 SW Jackson St., Ste. 420, Topeka, Kansas 66612-1367. Telephone: 785/296-5522. Send one to Water Well Owner and retain one for your records. Visit us at <http://www.kdheks.gov/geo/waterwells>.