

CORRECTION(S) TO WATER WELL RECORD (WWC-5)

(to rectify lacking or incorrect information)

County: Wichita

Location listed as:

Section-Township-Range: 17-18 S-35 W

Fraction ($\frac{1}{4}$ $\frac{1}{4}$ $\frac{1}{4}$): SE NE SE

Location changed to:

18-18 S-35 W

SE NE SE

Other changes: Initial statements: _____

Changed to: _____

Comments: _____

verification method: written description, locations of other monitoring wells for same project, and mapping tool & aerial photos on KGS website. initials: DR date: 9/25/2008

submitted by: Kansas Geological Survey, Data Resources Library, 1930 Constant Ave., Lawrence, KS 66047-3726
to: Kansas Dept of Health & Environment, Bureau of Water, 1000 SW Jackson, Suite 420, Topeka, KS 66612-1367.

1 LOCATION OF WATER WELL:	Fraction County: Wichita	SE ¼ NE ¼ SE ¼	Section Number 17	Township Number T 18 S	Range Number R 35 E W
---------------------------	-----------------------------	----------------------	----------------------	---------------------------	---------------------------------

Distance and direction from nearest town or city street address of well if located within city?

Scott Coop Marienthal, Kansas

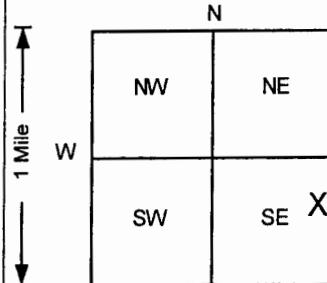
2 WATER WELL OWNER: Scott Cooperative Association

RR#, St Address, Box # P.O. Box 350

Board of Agriculture, Division of Water Resources

City, State, ZIP Code Scott City, Kansas 67871

Application Number:

3 LOCATE WELL'S LOCATION
WITH AN "X" IN SECTION BOX:

4 DEPTH OF COMPLETED WELL 130 ft. ELEVATION: 0

Depth(s) Groundwater Encountered 1 ft. 2 ft. 3 ft.

WELL'S STATIC WATER LEVEL ft below land surface measured on mo/day/yr

Pump test data: Well water was NA ft after hours pumping gpm

Est. Yield NA gpm: Well water was ft after hours pumping gpm

Bore Hole Diameter 8 in. to 130 ft, and in. to ft.

WELL WATER TO BE USED AS: 5 Public water supply 8 Air conditioning 11 Injection well

1 Domestic 3 Feedlot 6 Oil field water supply 9 Dewatering 12 Other (Specify below)

2 Irrigation 4 Industrial 7 Lawn and garden only 10 Monitoring well

Was a chemical/bacteriological sample submitted to Department? Yes No If yes, mo/day/yr sample was submitted

Water Well Disinfected? Yes No ✓

5 TYPE OF BLANK CASING USED: 5 Wrought iron 8 Concrete tile Casing joints: Glued Clamped

1 Steel 3 RMP (SR) 6 Asbestos-Cement 9 Other (specify below) Welded

2 PVC 4 ABS 7 Fiberglass Threaded. ✓

Blank casing diameter 4 in. to 90 ft, Dia in. to ft, Dia in. to ft.

Casing height above land surface in., weight lbs./ft. Wall thickness or gauge No. Sch. 40

6 TYPE OF SCREEN OR PERFORATION MATERIAL: 7 PVC 10 Asbestos-cement

1 Steel 3 Stainless steel 5 Fiberglass 8 RMP (SR) 11 Other (specify)

2 Brass 4 Galvanized steel 6 Concrete tile 9 ABS 12 None used (open hole)

SCREEN OR PERFORATION OPENINGS ARE: 5 Gauzed wrapped 8 Saw cut 11 None (open hole)

1 Continuous slot 3 Mill slot 6 Wire wrapped 9 Drilled holes

2 Louvered shutter 4 Key punched 7 Torch cut 10 Other (specify)

SCREEN-PERFORATED INTERVALS: From 90 ft to 130 ft, From ft to ft.

From ft to ft, From ft to ft, From ft to ft.

GRAVEL PACK INTERVALS: From 87 ft to 130 ft, From ft to ft.

From ft to ft, From ft to ft.

6 GROUT MATERIAL: 1 Neat cement 2 Cement grout 3 Bentonite 4 Other

Grout Intervals: From 0 ft to 3 ft, From 3 ft to 87 ft, From ft to ft.

What is the nearest source of possible contamination:

1 Septic tank 4 Lateral lines 7 Pit privy 10 Livestock pens 14 Abandoned water well

2 Sewer lines 5 Cess pool 8 Sewage lagoon 11 Fuel storage 15 Oil well/Gas well

3 Watertight sewer lines 6 Seepage pit 9 Feedyard 12 Fertilizer storage 16 Other (specify below)

How many feet? 0

Direction from well?

FROM	TO	LITHOLOGIC LOG	FROM	TO	PLUGGING INTERVALS
0	0.5	Asphalt,			
0.5	21	Clay, Dark Brown			
21	32	Clay, Light Brown			
32	53	Sand, Brown			
53	54	Caliche, Off White			
54	65	Sand, Brown			
65	75	Caliche, Off White			
75	81	Clay, Brown			
81	83	Sand, Brown			
83	90	Clay, Light Brown			
90	102	Clay, Light Brown			
102	107	Sand, Brown			
107	109	Caliche, Off White			SVE3R , Tag # 00295563 , Flushmount
109	130	Sand, Brown			Project Name: Greenfield - Scott Cooperative Association
					GeoCore # 831 , KDHE # U1 102 0802

7 CONTRACTOR'S OR LANDOWNER'S CERTIFICATION: This water well was (1) constructed, (2) reconstructed, or (3) plugged under my jurisdiction and was completed on (mo/day/year) 8/29/00 and this record is true to the best of my knowledge and belief.

Kansas Water Well Contractor's License No. 527 This Water Well Record was completed on (mo/day/yr) 9/21/00 under the business name of GeoCore Services, Inc. by (signature) *Dale Kelly*