

CORRECTION(S) TO WATER WELL RECORD (WWC-5)

(to rectify lacking or incorrect information)

Location listed as:

Section-Township-Range: 7-18 S-35 W

Fraction (¼ ¼ ¼): SE NE SE

County: Wichita

Location changed to:

18-18 S-35 W

SE NE SE

Other changes: Initial statements: _____

Changed to: _____

Comments: _____

verification method: written description, locations of other monitoring wells for same project, and mapping tool & aerial photos on KGS website.

initials: DR date: 9/25/2008

submitted by: Kansas Geological Survey, Data Resources Library, 1930 Constant Ave., Lawrence, KS 66047-3726
to: Kansas Dept of Health & Environment, Bureau of Water, 1000 SW Jackson, Suite 420, Topeka, KS 66612-1367.

1 LOCATION OF WATER WELL:	Fraction County: Wichita SE ¼	NE ¼	SE ¼	Section Number 7	Township Number T 18 S	Range Number R 35 E
---------------------------	-------------------------------------	------	------	---------------------	---------------------------	------------------------

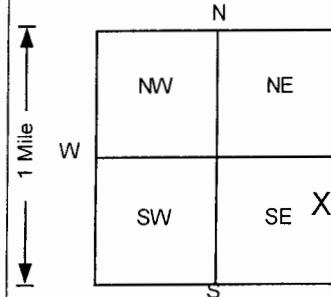
Distance and direction from nearest town or city street address of well if located within city?

Scott Coop, Marienthal, Kansas

2 WATER WELL OWNER: Scott Coop Association

P.O. Box 350

RR#, St. Address, Box #: Scott City, Kansas 67871

Board of Agriculture, Division of Water Resources
Application Number:3 LOCATE WELL'S LOCATION
WITH AN "X" IN SECTION BOX:

4 DEPTH OF COMPLETED WELL 130 ft. ELEVATION: 3218.8 ft.

Depth(s) Groundwater Encountered 1. ft. 2. ft. 3. ft.

WELL'S STATIC WATER LEVEL ft. below land surface measured on mo/day/yr

Pump test data: Well water was NA ft. after hours pumping gpm

Est. Yield .. NA... gpm: Well water was ft. after hours pumping gpm

Bore Hole Diameter 8 in. to 135 ft, and in. to ft.

WELL WATER TO BE USED AS: 5 Public water supply 8 Air conditioning 11 Injection well

1 Domestic 3 Feedlot 6 Oil field water supply 9 Dewatering 12 Other (Specify below)

2 Irrigation 4 Industrial 7 Lawn and garden only 10 Monitoring well

Was a chemical/bacteriological sample submitted to Department? Yes.....No.....; If yes, mo/day/yr sample was submitted

Water Well Disinfected? Yes No ✓

5 TYPE OF BLANK CASING USED: 5 Wrought iron 8 Concrete tile Casing JOINTS: Glued Clamped

1 Steel 3 RMP (SR) 6 Asbestos-Cement 9 Other (specify below) Welded

2 PVC 4 ABS 7 Fiberglass Threaded. ✓

Blank casing diameter 4 in. to 90 ft, Dia in. to ft, Dia in. to ft.

Casing height above land surface -2.04 in., weight lbs./ft. Wall thickness or gauge No. Sch. 40

TYPE OF SCREEN OR PERFORATION MATERIAL 7 PVC 10 Asbestos-cement

1 Steel 3 Stainless steel 5 Fiberglass 8 RMP (SR) 11 Other (specify)

2 Brass 4 Galvanized steel 6 Concrete tile 9 ABS 12 None used (open hole)

SCREEN OR PERFORATION OPENINGS ARE: 5 Gauzed wrapped 8 Saw cut 11 None (open hole)

1 Continuous slot 3 Mill slot 6 Wire wrapped 9 Drilled holes

2 Louvered shutter 4 Key punched 7 Torch cut 10 Other (specify)

SCREEN-PERFORATED INTERVALS: From 90 ft. to 130 ft., From ft. to ft.

From ft. to ft., From ft. to ft.

GRAVEL PACK INTERVALS: From 87 ft. to 135 ft., From ft. to ft.

From ft. to ft., From ft. to ft.

6 GROUT MATERIAL: 1 Neat cement 2 Cement grout 3 Bentonite 4 Other

Grout Intervals: From 3 ft. to 82 ft., From 82 ft. to 87 ft., From ft. to ft.

What is the nearest source of possible contamination: 10 Livestock pens 14 Abandoned water well

1 Septic tank 4 Lateral lines 7 Pit privy 11 Fuel storage 15 Oil well/Gas well

2 Sewer lines 5 Cess pool 8 Sewage lagoon 12 Fertilizer storage 16 Other (specify below)

3 Watertight sewer lines 6 Seepage pit 9 Feedyard 13 Insecticide storage

Former UST Basin

Direction from well? East

LITHOLOGIC LOG FROM TO PLUGGING INTERVALS

0 0.5 Asphalt,

0.5 25 Clay, Brown

25 34 Clay, Light Brown

34 67 Sand, Brown

67 75 Clay, Light Brown

75 84 Clay, Light Brown

84 96 Sand, Brown

96 100 Clay, Brown

100 111 Clay, Brown

111 135 Sand, Brown