

CORRECTION(S) TO WATER WELL RECORD (WWC-5)

(to rectify lacking or incorrect information)

County: Wichita

Location listed as:

Section-Township-Range: 7-18 S-35 W

Fraction (1/4 1/4 1/4): SE NE SE

Location changed to:

18-18 S-35 W

SE NE SE

Other changes: Initial statements: _____

Changed to: _____

Comments: _____

verification method: Written description, locations of other monitoring wells for same project, and mapping tool & aerial photos on KGS website.

initials: DR date: 9/25/2008

submitted by: Kansas Geological Survey, Data Resources Library, 1930 Constant Ave., Lawrence, KS 66047-3726
to: Kansas Dept of Health & Environment, Bureau of Water, 1000 SW Jackson, Suite 420, Topeka, KS 66612-1367.

1 LOCATION OF WATER WELL:		Fraction SE ¼	NE ¼	SE ¼	Section Number 7	Township Number T 18 S	Range Number R 35 E
---------------------------	--	------------------	------	------	---------------------	---------------------------	------------------------

County: Wichita

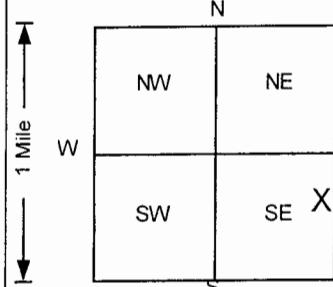
Distance and direction from nearest town or city street address of well if located within city?

Scott Coop, Marienthal, Kansas

2 WATER WELL OWNER: Scott Coop Association

P.O. Box 350

RR#, St. Address, Box #: Scott City, Kansas 67871

Board of Agriculture, Division of Water Resources
Application Number:3 LOCATE WELL'S LOCATION
WITH AN "X" IN SECTION BOX:

4 DEPTH OF COMPLETED WELL 130 ft. ELEVATION: 3220.25 ft.

Depth(s) Groundwater Encountered 1 ft. 2 ft. 3 ft.

WELL'S STATIC WATER LEVEL ft. below land surface measured on mo/day/yr ft.

Pump test data: Well water was NA ft. after hours pumping gpm

Est. Yield NA gpm: Well water was ft. after hours pumping gpm

Bore Hole Diameter 8 in. to 135 ft. and in. to ft.

WELL WATER TO BE USED AS: 5 Public water supply 8 Air conditioning 11 Injection well

1 Domestic 3 Feedlot 6 Oil field water supply 9 Dewatering

2 Irrigation 4 Industrial 7 Lawn and garden only 10 Monitoring well

Was a chemical/bacteriological sample submitted to Department? Yes No If yes, mo/day/yr sample was submitted

Water Well Disinfected? Yes No ✓

5 TYPE OF BLANK CASING USED:

1 Steel 3 RMP (SR)

2 PVC 4 ABS

5 Wrought iron

6 Asbestos-Cement

7 Fiberglass

8 Concrete tile

9 Other (specify below)

CASING JOINTS: Glued Clamped

Welded

Threaded. ✓

Blank casing diameter 2 in. to 90 ft. Dia in. to ft. Dia in. to ft.

Casing height above land surface -3 in. weight lbs./ft. Wall thickness or gauge No. Sch. 40

TYPE OF SCREEN OR PERFORATION MATERIAL

1 Steel 3 Stainless steel

2 Brass 4 Galvanized steel

5 Fiberglass

6 Concrete tile

7 PVC

8 RMP (SR)

9 ABS

10 Asbestos-cement

11 Other (specify)

12 None used (open hole)

SCREEN OR PERFORATION OPENINGS ARE:

1 Continuous slot 3 Mill slot

2 Louvered shutter 4 Key punched

5 Gauzed wrapped

6 Wire wrapped

7 Torch cut

8 Saw cut

9 Drilled holes

10 Other (specify)

11 None (open hole)

SCREEN-PERFORATED INTERVALS: From 90 ft. to 130 ft. From ft. to ft.

From ft. to ft. From ft. to ft.

GRAVEL PACK INTERVALS: From 87 ft. to 135 ft. From ft. to ft.

From ft. to ft. From ft. to ft.

6 GROUT MATERIAL: 1 Neat cement 2 Cement grout 3 Bentonite 4 Other

Grout Intervals: From 3 ft. to 82 ft. From 82 ft. to 87 ft. From ft. to ft.

What is the nearest source of possible contamination:

1 Septic tank 4 Lateral lines

2 Sewer lines 5 Cess pool

3 Watertight sewer lines 6 Seepage pit

7 Pit privy

8 Sewage lagoon

9 Feedyard

10 Livestock pens

11 Fuel storage

12 Fertilizer storage

13 Insecticide storage

14 Abandoned water well

15 Oil well/Gas well

16 Other (specify below)

Former UST Basin

Direction from well? West

How many feet? 75

FROM	TO	LITHOLOGIC LOG	FROM	TO	PLUGGING INTERVALS
0	0.5	Asphalt,			
0.5	21	Clay, Dark Brown			
21	32	Clay, Light Brown			
32	53	Sand, Brown			
53	54	Caliche, Off White			
54	65	Sand, Brown			
65	75	Caliche, Off White			
75	81	Clay, Brown			
81	83	Sand, Brown			
83	90	Clay, Light Brown			
90	102	Clay, Light Brown			
102	107	Sand, Brown			
107	109	Caliche, Off White			SVE3 , Tag # 00295563 , Flushmount
109	135	Sand, Brown			Project Name: Greenfield - Scott Cooperative Association
					GeoCore # 831 , KDHE # U1 102 0802

7 CONTRACTOR'S OR LANDOWNER'S CERTIFICATION: This water well was (1) constructed, (2) reconstructed, or (3) plugged under my jurisdiction and was completed on (mo/day/year) 3/23/00 and this record is true to the best of my knowledge and belief.

Kansas Water Well Contractor's License No. 527 This Water Well Record was completed on (mo/day/year) 4/21/00 under the business name of GeoCore Services, Inc. by (signature) *Dee Roll*