

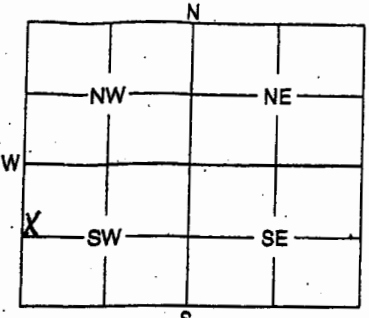
MW-7

WATER WELL PLUGGING RECORD

Form WWC-5P

KSA 82a-1212

ID NO. 00281007

1 LOCATION OF WATER WELL:	Fraction	Section Number	Township Number	Range Number												
County: <u>Wichita</u>	<u>SW 1/4 SW 1/4 NW 1/4 SW</u>	<u>17</u>	<u>18</u>	<u>35</u> EW												
Distance and direction from nearest town or city street address of well if located within city? <u>129 N. 120th Rd Marienthal, KS 67863</u>																
2 WATER WELL OWNER: <u>Scott Cooperative Association</u>																
RR #, St. Address, Box #: <u>P.O. Box 340</u>		Board of Agriculture, Division of Water Resources														
City, State, ZIP Code: <u>Scott City, KS 67871</u>		Application Number:														
3 MARK WELL'S LOCATION WITH AN "X" IN SECTION BOX: <div style="text-align: center;">  </div>		4 DEPTH OF WELL <u>150</u> ft.														
		WELL'S STATIC WATER LEVEL <u>129</u> ft.														
WELL WAS USED AS:																
<table style="width:100%;"> <tr> <td>1 Domestic</td> <td>5 Public Water Supply</td> <td>9 Dewatering</td> </tr> <tr> <td>2 Irrigation</td> <td>6 Oil Field Water Supply</td> <td>10 Monitoring Well</td> </tr> <tr> <td>3 Feedlot</td> <td>7 Domestic (Lawn & Garden)</td> <td>11 Injection Well</td> </tr> <tr> <td>4 Industrial</td> <td>8 Air Conditioning</td> <td>12 Other</td> </tr>
Was a chemical / bacteriological sample submitted to Department? Yes No <u>X</u>																
If yes, mo/day/yr sample was submitted																
Water Well Disinfected: Yes No <u>X</u>																

5 TYPE OF BLANK CASING USED:				
1 Steel	3 RMP (SR)	5 Wrought	7 Fiberglass	9 Other (Specify below)
2 PVC	4 ABS	6 Asbestos-Cement	8 Concrete Tile	
Blank casing diameter <u>4</u> in. Was casing pulled? Yes <u>X</u> No If yes, how much <u>3'</u>				
Casing height above or below land surface <u>36</u> in.				

6 GROUT PLUG MATERIAL: 1 Neat cement 2 Cement grout 3 <u>Bentonite</u> 4 Other				
Grout Plug Intervals: From <u>150</u> ft. to <u>3</u> ft. From ft. to ft. From ft. to ft.				
What is the nearest source of possible contamination:				
1 Septic tank	6 Seepage pit	11 Fuel storage	16 Other (specify below)	
2 Sewer lines	7 Pit privy	12 Fertilizer storage		
3 Watertight sewer lines	8 Sewage lagoon	13 Insecticide storage		
4 Lateral lines	9 Feedyard	14 Abandoned water well		
5 Cess pool	10 Livestock pens	15 Oil well/Gas well		
Direction from well? <u>W</u> How many feet? <u>110</u>				

FROM	TO	PLUGGING MATERIALS
150'	3'	Bentonite chips
3'	0'	Native material

7 CONTRACTOR'S OF LANDOWNER'S CERTIFICATION: This water well was plugged under my jurisdiction and was completed on (mo/day/year) <u>7-15-09</u> and this record is true to the best of my knowledge and belief. Kansas	
Water Well Contractor's License No. <u>7-16-09</u>	This Water Well Record was completed on (mo/day/year)
under the business name of <u>Green Field Contractors</u>	
by (signature) <u>John Pearson</u>	