

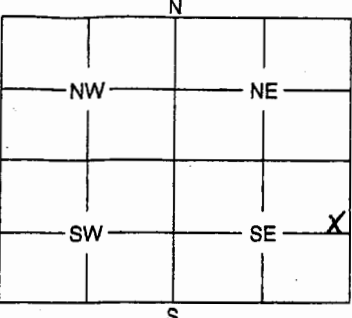
AS-7

WATER WELL PLUGGING RECORD

Form WWC-5P

KSA 82a-1212

ID NO. 00295600

1	LOCATION OF WATER WELL:	Fraction	Section Number	Township Number	Range Number																								
	County: <u>Wichita</u>	<u>SE 1/4 SE 1/4 NE 1/4 SE</u>	<u>18</u>	<u>18</u>	<u>35</u> EW																								
Distance and direction from nearest town or city street address of well if located within city? <u>129 N. 120th Rd Marienthal, KS 67863</u>																													
2	WATER WELL OWNER: <u>Scott Cooperative Association</u> RR #, St. Address, Box #: <u>P.O. Box 340</u> City, State, ZIP Code: <u>Scott City, KS 67871</u>																												
Board of Agriculture, Division of Water Resources Application Number:																													
3	MARK WELL'S LOCATION WITH AN "X" IN SECTION BOX:		4 DEPTH OF WELL <u>142</u> ft. WELL'S STATIC WATER LEVEL <u>130</u> ft. WELL WAS USED AS: <table style="width:100%; border: none;"> <tr> <td>1 Domestic</td> <td>5 Public Water Supply</td> <td>9 Dewatering</td> </tr> <tr> <td>2 Irrigation</td> <td>6 Oil Field Water Supply</td> <td>10 Monitoring Well</td> </tr> <tr> <td>3 Feedlot</td> <td>7 Domestic (Lawn & Garden)</td> <td><u>11</u> Injection Well</td> </tr> <tr> <td>4 Industrial</td> <td>8 Air Conditioning</td> <td>12 Other</td> </tr> </table>			1 Domestic	5 Public Water Supply	9 Dewatering	2 Irrigation	6 Oil Field Water Supply	10 Monitoring Well	3 Feedlot	7 Domestic (Lawn & Garden)	<u>11</u> Injection Well	4 Industrial	8 Air Conditioning	12 Other												
1 Domestic	5 Public Water Supply	9 Dewatering																											
2 Irrigation	6 Oil Field Water Supply	10 Monitoring Well																											
3 Feedlot	7 Domestic (Lawn & Garden)	<u>11</u> Injection Well																											
4 Industrial	8 Air Conditioning	12 Other																											
																													
Was a chemical / bacteriological sample submitted to Department? Yes No <u>X</u> If yes, mo/day/yr sample was submitted																													
Water Well Disinfected: Yes No <u>X</u>																													
5	TYPE OF BLANK CASING USED: <table style="width:100%; border: none;"> <tr> <td>1 Steel</td> <td>3 RMP (SR)</td> <td>5 Wrought</td> <td>7 Fiberglass</td> <td>9 Other (Specify below)</td> </tr> <tr> <td><u>2 PVC</u></td> <td>4 ABS</td> <td>6 Asbestos-Cement</td> <td>8 Concrete Tile</td> <td></td> </tr> </table> Blank casing diameter <u>2</u> in. Was casing pulled? Yes <u>X</u> No If yes, how much <u>3'</u> Casing height above or below land surface <u>36</u> in.					1 Steel	3 RMP (SR)	5 Wrought	7 Fiberglass	9 Other (Specify below)	<u>2 PVC</u>	4 ABS	6 Asbestos-Cement	8 Concrete Tile															
1 Steel	3 RMP (SR)	5 Wrought	7 Fiberglass	9 Other (Specify below)																									
<u>2 PVC</u>	4 ABS	6 Asbestos-Cement	8 Concrete Tile																										
6	GROUT PLUG MATERIAL: 1 Neat cement 2 Cement grout <u>3</u> Bentonite 4 Other Grout Plug Intervals: From <u>142</u> ft. to <u>3</u> ft., From ft. to ft., From to ft. What is the nearest source of possible contamination: <table style="width:100%; border: none;"> <tr> <td>1 Septic tank</td> <td>6 Seepage pit</td> <td><u>11</u> Fuel storage</td> <td>16 Other (specify below)</td> </tr> <tr> <td>2 Sewer lines</td> <td>7 Pit privy</td> <td>12 Fertilizer storage</td> <td></td> </tr> <tr> <td>3 Watertight sewer lines</td> <td>8 Sewage lagoon</td> <td>13 Insecticide storage</td> <td></td> </tr> <tr> <td>4 Lateral lines</td> <td>9 Feedyard</td> <td>14 Abandoned water well</td> <td></td> </tr> <tr> <td>5 Cess pool</td> <td>10 Livestock pens</td> <td>15 Oil well/Gas well</td> <td></td> </tr> </table> Direction from well? <u>S</u> How many feet? <u>60</u>					1 Septic tank	6 Seepage pit	<u>11</u> Fuel storage	16 Other (specify below)	2 Sewer lines	7 Pit privy	12 Fertilizer storage		3 Watertight sewer lines	8 Sewage lagoon	13 Insecticide storage		4 Lateral lines	9 Feedyard	14 Abandoned water well		5 Cess pool	10 Livestock pens	15 Oil well/Gas well					
1 Septic tank	6 Seepage pit	<u>11</u> Fuel storage	16 Other (specify below)																										
2 Sewer lines	7 Pit privy	12 Fertilizer storage																											
3 Watertight sewer lines	8 Sewage lagoon	13 Insecticide storage																											
4 Lateral lines	9 Feedyard	14 Abandoned water well																											
5 Cess pool	10 Livestock pens	15 Oil well/Gas well																											
<table border="1" style="width:100%; border-collapse: collapse;"> <thead> <tr> <th style="width:15%;">FROM</th> <th style="width:15%;">TO</th> <th style="width:70%;">PLUGGING MATERIALS</th> </tr> </thead> <tbody> <tr> <td><u>142'</u></td> <td><u>3'</u></td> <td><u>Bentonite chips</u></td> </tr> <tr> <td><u>3'</u></td> <td><u>0'</u></td> <td><u>Native material</u></td> </tr> <tr><td> </td><td> </td><td> </td></tr> <tr><td> </td><td> </td><td> </td></tr> <tr><td> </td><td> </td><td> </td></tr> <tr><td> </td><td> </td><td> </td></tr> <tr><td> </td><td> </td><td> </td></tr> </tbody> </table>						FROM	TO	PLUGGING MATERIALS	<u>142'</u>	<u>3'</u>	<u>Bentonite chips</u>	<u>3'</u>	<u>0'</u>	<u>Native material</u>															
FROM	TO	PLUGGING MATERIALS																											
<u>142'</u>	<u>3'</u>	<u>Bentonite chips</u>																											
<u>3'</u>	<u>0'</u>	<u>Native material</u>																											
7	CONTRACTOR'S OF LANDOWNER'S CERTIFICATION: This water well was plugged under my jurisdiction and was completed on (mo/day/year) <u>7-10-09</u> and this record is true to the best of my knowledge and belief. Kansas Water Well Contractor's License No. <u>7-16-09</u> under the business name of <u>GreenField Contractors</u> . This Water Well Record was completed on (mo/day/year) <u>7-16-09</u> by (signature) <u>John Pearson</u>																												

INSTRUCTIONS: Use typewriter or ball point pen. Please press firmly and print clearly. Please fill in blanks, underline or circle the correct answers. Send top three copies to Kansas Department of Health and Environment, Bureau of Water, Geology Section, 1000 SW Jackson