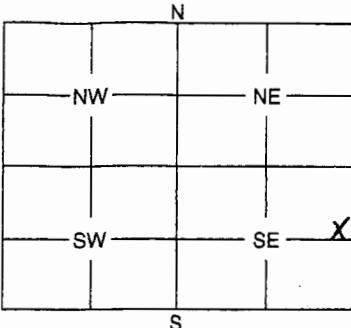


MW - 6

WATER WELL PLUGGING RECORD Form WWC-5P KSA 82a-1212 ID NO. 00280851

1	LOCATION OF WATER WELL:	Fraction	Section Number	Township Number	Range Number																				
County: Wichita		SE $\frac{1}{4}$ SE $\frac{1}{4}$ NE $\frac{1}{4}$ SE	18	18	35																				
Distance and direction from nearest town or city street address of well if located within city?																									
129 N. 120th Rd Marienthal, KS 67863																									
2	WATER WELL OWNER:	Scott Cooperative Association																							
RR #, St. Address, Box #:		P.O. Box 340																							
City, State, ZIP Code		Board of Agriculture, Division of Water Resources Application Number: Scott City, KS 67871																							
3	MARK WELL'S LOCATION WITH AN "X" IN SECTION BOX:	4	DEPTH OF WELL ..... 150 ft.																						
		WELL'S STATIC WATER LEVEL ..... 130 ft.																							
WELL WAS USED AS:																									
<table border="0"> <tr> <td>1 Domestic</td> <td>5 Public Water Supply</td> <td>9 Dewatering</td> </tr> <tr> <td>2 Irrigation</td> <td>6 Oil Field Water Supply</td> <td>10 Monitoring Well</td> </tr> <tr> <td>3 Feedlot</td> <td>7 Domestic (Lawn &amp; Garden)</td> <td>11 Injection Well</td> </tr> <tr> <td>4 Industrial</td> <td>8 Air Conditioning</td> <td>12 Other</td> </tr> </table>						1 Domestic	5 Public Water Supply	9 Dewatering	2 Irrigation	6 Oil Field Water Supply	10 Monitoring Well	3 Feedlot	7 Domestic (Lawn & Garden)	11 Injection Well	4 Industrial	8 Air Conditioning	12 Other								
1 Domestic	5 Public Water Supply	9 Dewatering																							
2 Irrigation	6 Oil Field Water Supply	10 Monitoring Well																							
3 Feedlot	7 Domestic (Lawn & Garden)	11 Injection Well																							
4 Industrial	8 Air Conditioning	12 Other																							
Was a chemical / bacteriological sample submitted to Department? Yes ..... No ..... X																									
If yes, mo/day/yr sample was submitted .....																									
Water Well Disinfected: Yes ..... No ..... X																									
5	TYPE OF BLANK CASING USED:																								
<table border="0"> <tr> <td>1 Steel</td> <td>3 RMP (SR)</td> <td>5 Wrought</td> <td>7 Fiberglass</td> <td>9 Other (Specify below)</td> </tr> <tr> <td>2 PVC</td> <td>4 ABS</td> <td>6 Asbestos-Cement</td> <td>8 Concrete Tile</td> <td>.....</td> </tr> </table>						1 Steel	3 RMP (SR)	5 Wrought	7 Fiberglass	9 Other (Specify below)	2 PVC	4 ABS	6 Asbestos-Cement	8 Concrete Tile	.....										
1 Steel	3 RMP (SR)	5 Wrought	7 Fiberglass	9 Other (Specify below)																					
2 PVC	4 ABS	6 Asbestos-Cement	8 Concrete Tile	.....																					
Blank casing diameter ..... 4 in.		Was casing pulled? Yes ..... X		No ..... If yes, how much ..... 3'																					
Casing height above or below land surface ..... 36 in.																									
6	GROUT PLUG MATERIAL: 1 Neat cement 2 Cement grout 3 Bentonite 4 Other																								
Grout Plug Intervals: From 150 ft. to 3 ft., From ..... ft. to ..... ft., From ..... ft. to ..... ft.																									
What is the nearest source of possible contamination:																									
<table border="0"> <tr> <td>1 Septic tank</td> <td>6 Seepage pit</td> <td>11 Fuel storage</td> <td>16 Other (specify below)</td> </tr> <tr> <td>2 Sewer lines</td> <td>7 Pit privy</td> <td>12 Fertilizer storage</td> <td>.....</td> </tr> <tr> <td>3 Watertight sewer lines</td> <td>8 Sewage lagoon</td> <td>13 Insecticide storage</td> <td>.....</td> </tr> <tr> <td>4 Lateral lines</td> <td>9 Feedyard</td> <td>14 Abandoned water well</td> <td>.....</td> </tr> <tr> <td>5 Cess pool</td> <td>10 Livestock pens</td> <td>15 Oil well/Gas well</td> <td>.....</td> </tr> </table>						1 Septic tank	6 Seepage pit	11 Fuel storage	16 Other (specify below)	2 Sewer lines	7 Pit privy	12 Fertilizer storage	.....	3 Watertight sewer lines	8 Sewage lagoon	13 Insecticide storage	.....	4 Lateral lines	9 Feedyard	14 Abandoned water well	.....	5 Cess pool	10 Livestock pens	15 Oil well/Gas well	.....
1 Septic tank	6 Seepage pit	11 Fuel storage	16 Other (specify below)																						
2 Sewer lines	7 Pit privy	12 Fertilizer storage	.....																						
3 Watertight sewer lines	8 Sewage lagoon	13 Insecticide storage	.....																						
4 Lateral lines	9 Feedyard	14 Abandoned water well	.....																						
5 Cess pool	10 Livestock pens	15 Oil well/Gas well	.....																						
Direction from well? SW How many feet? 100																									
FROM	TO	PLUGGING MATERIALS																							
150'	3'	Bentonite chips																							
3'	0'	Native material																							
7	CONTRACTOR'S OF LANDOWNER'S CERTIFICATION: This water well was plugged under my jurisdiction and was completed on (mo/day/year) 7-14-09 and this record is true to the best of my knowledge and belief. Kansas Water Well Contractor's License No. ..... This Water Well Record was completed on (mo/day/year) 7-16-09 under the business name of GreenField Contractors by (signature) Jean Peeler																								
INSTRUCTIONS: Use typewriter or ball point pen. Please press firmly and print clearly. Please fill in blanks, underline or circle the correct answers. Send top three copies to Kansas Department of Health and Environment, Bureau of Water, Geology Section, 1000 SW Jackson St., Ste. 420, Topeka, Kansas 66612-1367. Telephone: 785/296-5522. Send one to Water Well Owner and retain one for your records.																									