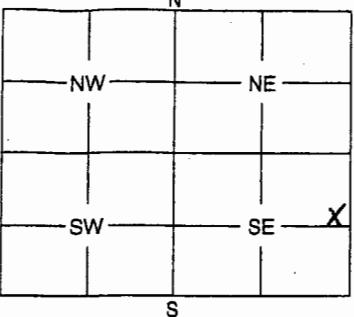


OB-1

WATER WELL PLUGGING RECORD Form WWC-5P KSA 82a-1212 ID NO. 00280950

1	LOCATION OF WATER WELL:	Fraction	Section Number	Township Number	Range Number												
County: <u>Wichita</u>		<u>SE 1/4 SE 1/4 NE 1/4 SE</u>	<u>18</u>	<u>18</u>	<u>35</u>												
Distance and direction from nearest town or city street address of well if located within city? <u>129 N. 120th Rd Marienthal, KS 67863</u>																	
2	WATER WELL OWNER:	<u>Scott Cooperative Association</u> P.O. Box 340															
RR #, St. Address, Box #: City, State, ZIP Code		Board of Agriculture, Division of Water Resources Application Number:															
3	MARK WELL'S LOCATION WITH AN "X" IN SECTION BOX:	4	DEPTH OF WELL <u>150</u> ft.														
		WELL'S STATIC WATER LEVEL <u>129</u> ft.															
WELL WAS USED AS:																	
<table border="0"> <tr> <td>1 Domestic</td> <td>5 Public Water Supply</td> <td>9 Dewatering</td> </tr> <tr> <td>2 Irrigation</td> <td>6 Oil Field Water Supply</td> <td>10 Monitoring Well</td> </tr> <tr> <td>3 Feedlot</td> <td>7 Domestic (Lawn & Garden)</td> <td>11 Injection Well</td> </tr> <tr> <td>4 Industrial</td> <td>8 Air Conditioning</td> <td>12 Other</td> </tr>
Was a chemical / bacteriological sample submitted to Department? Yes No <u>X</u> If yes, mo/day/yr sample was submitted																	
Water Well Disinfected: Yes No <u>X</u>																	
5	TYPE OF BLANK CASING USED:																
<input checked="" type="radio"/> 1 Steel <input type="radio"/> 3 RMP (SR) <input type="radio"/> 5 Wrought <input type="radio"/> 7 Fiberglass <input type="radio"/> 9 Other (Specify below) <input checked="" type="radio"/> 2 PVC <input type="radio"/> 4 ABS <input type="radio"/> 6 Asbestos-Cement <input type="radio"/> 8 Concrete Tile																	
Blank casing diameter <u>4</u> in.		Was casing pulled? Yes <u>X</u>		No If yes, how much <u>3'</u>													
Casing height above or <u>below</u> land surface <u>36</u> in.																	
6	GROUT PLUG MATERIAL: 1 Neat cement 2 Cement grout <input checked="" type="radio"/> 3 Bentonite 4 Other																
Grout Plug Intervals: From <u>150</u> ft. to <u>3</u> ft., From ft. to ft., From ft. to ft.																	
What is the nearest source of possible contamination:																	
<input type="radio"/> 1 Septic tank <input type="radio"/> 2 Sewer lines <input type="radio"/> 3 Watertight sewer lines <input type="radio"/> 4 Lateral lines <input type="radio"/> 5 Cess pool		<input type="radio"/> 6 Seepage pit <input type="radio"/> 7 Pit privy <input type="radio"/> 8 Sewage lagoon <input type="radio"/> 9 Feedyard <input type="radio"/> 10 Livestock pens		<input type="radio"/> 11 Fuel storage <input type="radio"/> 12 Fertilizer storage <input type="radio"/> 13 Insecticide storage <input type="radio"/> 14 Abandoned water well <input type="radio"/> 15 Oil well/Gas well													
Direction from well? <u>SW</u> How many feet? <u>40</u>																	
FROM	TO	PLUGGING MATERIALS															
<u>150'</u>	<u>3'</u>	<u>Bentonite chips</u>															
<u>3'</u>	<u>0'</u>	<u>Native material</u>															
7	CONTRACTOR'S OF LANDOWNER'S CERTIFICATION: This water well was plugged under my jurisdiction and was completed on (mo/day/year) <u>7-14-09</u> and this record is true to the best of my knowledge and belief. Kansas Water Well Contractor's License No. <u>7-16-09</u> This Water Well Record was completed on (mo/day/year) <u>7-16-09</u> under the business name of <u>GreenField Contractors</u> by (signature) <u>John Pearson</u>																

INSTRUCTIONS: Use typewriter or ball point pen. Please press firmly and print clearly. Please fill in blanks, underline or circle the correct answers. Send top three copies to Kansas Department of Health and Environment, Bureau of Water, Geology Section, 1000 SW Jackson