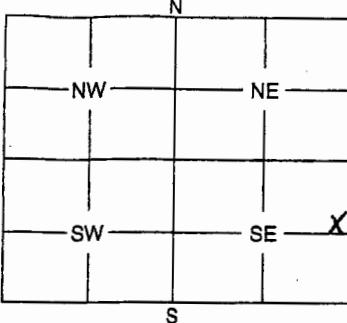


SU-1

WATER WELL PLUGGING RECORD Form WWC-5P KSA 82a-1212 ID NO. 00280929

1	LOCATION OF WATER WELL:	Fraction	Section Number	Township Number	Range Number
County: Wichita		SE $\frac{1}{4}$ SE $\frac{1}{4}$ NE $\frac{1}{4}$ SE	18	18	35
Distance and direction from nearest town or city street address of well if located within city? 129 N. 120th Rd Marienthal, KS 67863					
2	WATER WELL OWNER:	Scott Cooperative Association			
RR #, St. Address, Box #: City, State, ZIP Code		P.O. Box 340 Scott City, KS 67871			
3		Board of Agriculture, Division of Water Resources Application Number:			
MARK WELL'S LOCATION WITH AN "X" IN SECTION BOX:		4	DEPTH OF WELL ..... 130 ft.	WELL'S STATIC WATER LEVEL ..... N.A. ft.	
				WELL WAS USED AS:	
				1 Domestic 5 Public Water Supply 2 Irrigation 6 Oil Field Water Supply 3 Feedlot 7 Domestic (Lawn & Garden) 4 Industrial 8 Air Conditioning 9 Dewatering 10 Monitoring Well 11 Injection Well 12 Other SUE	
Was a chemical / bacteriological sample submitted to Department? Yes ..... No ..... X If yes, mo/day/yr sample was submitted .....					
Water Well Disinfected: Yes ..... No ..... X					
5	TYPE OF BLANK CASING USED:				
1 Steel 3 RMP (SR) 5 Wrought 7 Fiberglass 9 Other (Specify below) 2 PVC 4 ABS 6 Asbestos-Cement 8 Concrete Tile					
Blank casing diameter ..... 2 in.		Was casing pulled? Yes ..... X		No ..... If yes, how much ..... 3'	
Casing height above or below land surface ..... 36 in.					
6	GROUT PLUG MATERIAL: 1 Neat cement 2 Cement grout 3 Bentonite 4 Other				
Grout Plug Intervals: From 130 ft. to 3 ft., From ..... ft. to ..... ft., From ..... ft. to ..... ft.					
What is the nearest source of possible contamination:					
1 Septic tank 6 Seepage pit 11 Fuel storage 16 Other (specify below) 2 Sewer lines 7 Pit privy 12 Fertilizer storage ..... 3 Watertight sewer lines 8 Sewage lagoon 13 Insecticide storage ..... 4 Lateral lines 9 Feedyard 14 Abandoned water well ..... 5 Cess pool 10 Livestock pens 15 Oil well/Gas well					
Direction from well? ..... S How many feet? ..... 60					
FROM	TO	PLUGGING MATERIALS			
130'	3'	Bentonite chips			
3'	0'	Native material			
7	CONTRACTOR'S OF LANDOWNER'S CERTIFICATION: This water well was plugged under my jurisdiction and was completed on (mo/day/year) 7-9-09 and this record is true to the best of my knowledge and belief. Kansas				
Water Well Contractor's License No. ..... This Water Well Record was completed on (mo/day/year) 7-16-09 under the business name of Green Field Contractors					
by (signature) John Peeler					

INSTRUCTIONS: Use typewriter or ball point pen. Please press firmly and print clearly. Please fill in blanks, underline or circle the correct answers. Send top three copies to Kansas Department of Health and Environment, Bureau of Water, Geology Section, 1000 SW Jackson