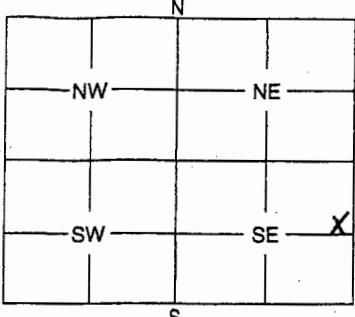


SU-4R

WATER WELL PLUGGING RECORD Form WWC-5P KSA 82a-1212 ID NO. 00295426

1	LOCATION OF WATER WELL:	Fraction	Section Number	Township Number	Range Number																								
County: Wichita		SE 1/4 SE 1/4 NE 1/4 SE	18	18	35																								
Distance and direction from nearest town or city street address of well if located within city? 129 N. 120th Rd Marienthal, KS 67863																													
2	WATER WELL OWNER:	Scott Cooperative Association P.O. Box 340																											
RR #, St. Address, Box #: City, State, ZIP Code		Board of Agriculture, Division of Water Resources Application Number:																											
3	MARK WELL'S LOCATION WITH AN "X" IN SECTION BOX:	4	DEPTH OF WELL 130 ft.																										
		WELL'S STATIC WATER LEVEL NA ft.																											
WELL WAS USED AS:																													
<table border="0"> <tr> <td>1 Domestic</td> <td>5 Public Water Supply</td> <td>9 Dewatering</td> </tr> <tr> <td>2 Irrigation</td> <td>6 Oil Field Water Supply</td> <td>10 Monitoring Well</td> </tr> <tr> <td>3 Feedlot</td> <td>7 Domestic (Lawn & Garden)</td> <td>11 Injection Well</td> </tr> <tr> <td>4 Industrial</td> <td>8 Air Conditioning</td> <td>12 Other SUE</td> </tr> </table>						1 Domestic	5 Public Water Supply	9 Dewatering	2 Irrigation	6 Oil Field Water Supply	10 Monitoring Well	3 Feedlot	7 Domestic (Lawn & Garden)	11 Injection Well	4 Industrial	8 Air Conditioning	12 Other SUE												
1 Domestic	5 Public Water Supply	9 Dewatering																											
2 Irrigation	6 Oil Field Water Supply	10 Monitoring Well																											
3 Feedlot	7 Domestic (Lawn & Garden)	11 Injection Well																											
4 Industrial	8 Air Conditioning	12 Other SUE																											
Was a chemical / bacteriological sample submitted to Department? Yes No <input checked="" type="checkbox"/> If yes, mo/day/yr sample was submitted																													
Water Well Disinfected: Yes No <input checked="" type="checkbox"/>																													
5	TYPE OF BLANK CASING USED:																												
<input checked="" type="checkbox"/> 1 Steel <input type="checkbox"/> 3 RMP (SR) <input type="checkbox"/> 5 Wrought <input type="checkbox"/> 7 Fiberglass <input type="checkbox"/> 9 Other (Specify below) <input checked="" type="checkbox"/> 2 PVC <input type="checkbox"/> 4 ABS <input type="checkbox"/> 6 Asbestos-Cement <input type="checkbox"/> 8 Concrete Tile																													
Blank casing diameter <u>4</u> in. Was casing pulled? Yes <input checked="" type="checkbox"/> No If yes, how much <u>3'</u> Casing height above or <u>below</u> land surface <u>36</u> in.																													
6	GROUT PLUG MATERIAL: 1 Neat cement 2 Cement grout <input checked="" type="checkbox"/> 3 Bentonite 4 Other																												
Grout Plug Intervals: From <u>130</u> ft. to <u>3</u> ft. From ft. to ft. From ft. to ft.																													
What is the nearest source of possible contamination:																													
<table border="0"> <tr> <td>1 Septic tank</td> <td>6 Seepage pit</td> <td><input checked="" type="checkbox"/> 11 Fuel storage</td> <td>16 Other (specify below)</td> </tr> <tr> <td>2 Sewer lines</td> <td>7 Pit privy</td> <td>12 Fertilizer storage</td> <td>.....</td> </tr> <tr> <td>3 Watertight sewer lines</td> <td>8 Sewage lagoon</td> <td>13 Insecticide storage</td> <td>.....</td> </tr> <tr> <td>4 Lateral lines</td> <td>9 Feedyard</td> <td>14 Abandoned water well</td> <td>.....</td> </tr> <tr> <td>5 Cess pool</td> <td>10 Livestock pens</td> <td>15 Oil well/Gas well</td> <td>.....</td> </tr> </table>						1 Septic tank	6 Seepage pit	<input checked="" type="checkbox"/> 11 Fuel storage	16 Other (specify below)	2 Sewer lines	7 Pit privy	12 Fertilizer storage	3 Watertight sewer lines	8 Sewage lagoon	13 Insecticide storage	4 Lateral lines	9 Feedyard	14 Abandoned water well	5 Cess pool	10 Livestock pens	15 Oil well/Gas well				
1 Septic tank	6 Seepage pit	<input checked="" type="checkbox"/> 11 Fuel storage	16 Other (specify below)																										
2 Sewer lines	7 Pit privy	12 Fertilizer storage																										
3 Watertight sewer lines	8 Sewage lagoon	13 Insecticide storage																										
4 Lateral lines	9 Feedyard	14 Abandoned water well																										
5 Cess pool	10 Livestock pens	15 Oil well/Gas well																										
Direction from well? <u>S</u> How many feet? <u>70</u>																													
<table border="1"> <thead> <tr> <th>FROM</th> <th>TO</th> <th>PLUGGING MATERIALS</th> </tr> </thead> <tbody> <tr> <td><u>130'</u></td> <td><u>3'</u></td> <td><u>Bentonite chips</u></td> </tr> <tr> <td><u>3'</u></td> <td><u>0'</u></td> <td><u>Native material</u></td> </tr> <tr><td> </td><td> </td><td> </td></tr> </tbody> </table>						FROM	TO	PLUGGING MATERIALS	<u>130'</u>	<u>3'</u>	<u>Bentonite chips</u>	<u>3'</u>	<u>0'</u>	<u>Native material</u>															
FROM	TO	PLUGGING MATERIALS																											
<u>130'</u>	<u>3'</u>	<u>Bentonite chips</u>																											
<u>3'</u>	<u>0'</u>	<u>Native material</u>																											
7	CONTRACTOR'S OF LANDOWNER'S CERTIFICATION: This water well was plugged under my jurisdiction and was completed on (mo/day/year) <u>7-10-09</u> and this record is true to the best of my knowledge and belief. Kansas Water Well Contractor's License No. <u>7-16-09</u> under the business name of <u>GreenField Contractors</u> by (signature) <u>John Pearson</u>																												

INSTRUCTIONS: Use typewriter or ball point pen. Please press firmly and print clearly. Please fill in blanks, underline or circle the correct answers. Send top three copies to Kansas Department of Health and Environment, Bureau of Water, Geology Section, 1000 SW Jackson