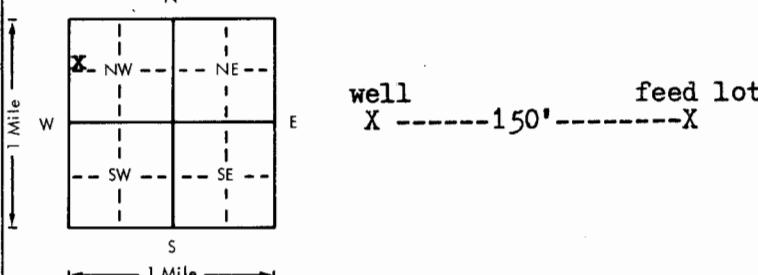


USE TYPEWRITER OR BALL
POINT PEN-PRESS FIRMLY,
PRINT CLEARLY.

WATER WELL RECORD
KSA 82a-1201-1215

Kansas Department of Health and
Environment-Division of Environment
(Water well Contractors)
Topeka, Kansas 66620

1. Location of well:	County Wichita	Fraction S/W $1/4$ N/W $1/4$ N/W $1/4$	Section number 26	Township number T 18	Range number S R 35 $\frac{1}{4}W$
2. Distance and direction from nearest town or city: 14 W, $1\frac{1}{2}$ W of Scott City, Kansas	Street address of well location if in city: N	3. Owner of well: R.R. or street: City, state, zip code: Victor Graff Box 55 Marienthal, Kansas 67863			
4. Locate with "X" in section below:	Sketch map: 			6. Bore hole dia. <u>9</u> in. Completion date <u>1/20/1978</u> Well depth <u>110</u> ft.	
5. Type and color of material	From	To	7. <input type="checkbox"/> Cable tool <input checked="" type="checkbox"/> Rotary <input type="checkbox"/> Driven <input type="checkbox"/> Dug <input type="checkbox"/> Hollow rod <input type="checkbox"/> Jetted <input type="checkbox"/> Bored <input type="checkbox"/> Reverse rotary		
Clay	0	25	8. Use: <input checked="" type="checkbox"/> Domestic <input type="checkbox"/> Public supply <input type="checkbox"/> Industry <input type="checkbox"/> Irrigation <input type="checkbox"/> Air conditioning <input type="checkbox"/> Stock <input type="checkbox"/> Lawn <input type="checkbox"/> Oil field water <input type="checkbox"/> Other		
Gyp	25	43	9. Casing: Material <input checked="" type="checkbox"/> Plastic <input type="checkbox"/> Wood <input type="checkbox"/> Copper Threaded <input type="checkbox"/> Welded <input checked="" type="checkbox"/> glue <input type="checkbox"/> Surface <u>12</u> in. RMP <input checked="" type="checkbox"/> PVC <input type="checkbox"/> Weight <u>1.8</u> lbs./ft. Dia. <u>5</u> in. to <u>90</u> ft. depth <input type="checkbox"/> Wall Thickness: inches or Dia. <input type="checkbox"/> in. to <input type="checkbox"/> ft. depth <input type="checkbox"/> gage No. <u>250</u>		
Clay sandy	43	46	10. Screen: Manufacturer's name <input checked="" type="checkbox"/> Jess & Lowell Type <input checked="" type="checkbox"/> RMP Dia. <u>5"</u> Slot/gauge <u>1/16"</u> Length <u>20'</u> Set between <u>90</u> ft. and <u>110</u> ft. <input type="checkbox"/> ft. and <input type="checkbox"/> ft. Gravel pack? <input checked="" type="checkbox"/> yes Size range of material <u>1/4-1/8"</u>		
Sand rock H	46	50	11. Static water level: <u>90</u> ft. below land surface Date <u>1/18/78</u>		
Sandy clay T	50	69	12. Pumping level below land surfaces: <u>105</u> ft. after <u>2</u> hrs. pumping <u>10</u> g.p.m. <input type="checkbox"/> ft. after <input type="checkbox"/> hrs. pumping <input type="checkbox"/> g.p.m. Estimated maximum yield <u>10</u> g.p.m.		
Sand rock H	69	74	13. Water sample submitted: <input type="checkbox"/> Yes <input checked="" type="checkbox"/> No Date <input type="checkbox"/>		
Fine sand clay T	74	85	14. Well head completion: <input checked="" type="checkbox"/> Pitless adapter <u>12</u> Inches above grade		
Sand rock H	85	94	15. Well grouted? <input checked="" type="checkbox"/> yes With: <input checked="" type="checkbox"/> Neat cement <input type="checkbox"/> Bentonite <input type="checkbox"/> Concrete Depth: From <u>0</u> ft. to <u>15</u> ft.		
Med. sand clay	94	105	16. Nearest source of possible contamination: fr. <u>150</u> Direction <u>east</u> Type <u>feed lot</u> Well disinfected upon completion? <input checked="" type="checkbox"/> Yes <input type="checkbox"/> No		
Clay yellow	105	110	17. Pump: Manufacturer's name <input checked="" type="checkbox"/> Red Jacket Model number <u>75N1-12BG</u> <u>3/4</u> Volts <u>230</u> Length of drop pipe <u>103</u> ft. capacity <u>10</u> g.p.m. Type: <input checked="" type="checkbox"/> Submersible <input type="checkbox"/> Turbine <input type="checkbox"/> Jet <input type="checkbox"/> Reciprocating <input type="checkbox"/> Centrifugal <input type="checkbox"/> Other		
(Use a second sheet if needed)			18. Elevation: Topography: <input type="checkbox"/> Hill <input type="checkbox"/> Slope <input checked="" type="checkbox"/> Upland <input type="checkbox"/> Valley		
19. Remarks:			20. Water well contractor's certification: This well was drilled under my jurisdiction and this report is true to the best of my knowledge and belief. <u>Weishaar Drilling & Sup. 232</u> Business name <u>Scott City, Ks. 67871</u> License No. Address <u>1/20/78</u> Signed <u>John Weishaar</u> Date <u>1/20/78</u> Authorized Representative		