

1 LOCATION OF WATER WELL: COUNTY: 102 WICHITA	Fraction SE 1/4 SE 1/4 SW 1/4	Section Number 17	Township Number T 18 S	Range Number R 36 W
--	----------------------------------	----------------------	---------------------------	------------------------

Distance and direction from nearest town or city street address of well if located within city?  
FROM LEBOTI; APPX 2 1/2 MILES EAST

2 WATER WELL OWNER: ESE ALCOHOL PLANT *Taylor & Assoc.*

RR#, St. Address, Box #: 509 N. 6TH  
City, State, ZIP code : GARDEN CITY, KS 67846-5508

Board of Agriculture, Division of Water Resources  
Application Number:


3 LOCATE WELL'S LOCATION WITH  
AN "X" IN SECTION BOX:

4 DEPTH OF COMPLETED WELL 173 ELEVATION: 0

Depth(s) Groundwater Encountered 1. 0 ft. 2. 0 ft. 3. 0 ft.

WELL'S STATIC WATER LEVEL 1/42 ft. below land surface measured on mo/day/yr *8/12/05*

Pump testdata: Well water was 0 ft. after 0 hours pumping 0 gpm

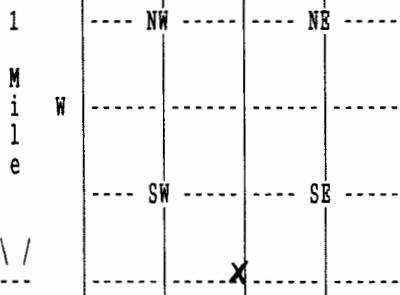

Estimated Yield 0 gpm: Well water was 0 ft. after 0 hours pumping 0 gpm

M E Bore Hole Diameter 7 1/2 in. to 173 ft., and in. to 0 ft.

W E WELL WATER TO BE USED AS: 10 MONITORING

Was a chemical/bacteriological sample submitted to department? No ;  
If yes, mo/day/yr sample was submitted Water well disinfected? Yes

## 5 TYPE OF BLANK CASING USED: 02 PVC

CASING JOINTS: **THREADED**

Blank casing diameter 4 in. to 173 ft., Dia in. to 0 ft., Dia in. to 0 ft.

Casing height above land surface 12 in., weight 2 lbs/ft. Wall thickness or gauge No. .237

TYPE OF SCREEN OR PERFORATION MATERIAL: 07 PVC

SCREEN OR PERFORATION OPENINGS ARE: 01 CONT. SLOT

SCREEN PERFORATED INTERVALS: From 133 ft. to 173 ft., From 0 ft. to 0 ft.

From 0 ft. to 0 ft., From 0 ft. to 0 ft.

GRAVEL PACK INTERVALS: From 128 ft. to 173 ft., From 0 ft. to 0 ft.

From 0 ft. to 0 ft., From 0 ft. to 0 ft.

## 6 GROUT MATERIAL 03 BENTONITE

Grout Intervals: From 0 ft. to 128 ft., From 0 ft. to 0 ft., From 0 ft. to 0 ft.

What is the nearest source of possible contamination: **NONE OBSERVED**

Direction from well?

How many feet? 0

FROM	TO	LITHOLOGIC LOG	FROM	TO	PLUGGING INTERVALS
0	2	02 SILT			
2	37	04 SANDY CLAY			
37	77	05 SAND			
77	85	04 SANDY CLAY			
85	91	05 SAND			
91	96	04 SANDY CLAY			
96	168	05 SAND			
168	175	04 SANDY CLAY			
175	180	19 SHALE			

7 CONTRACTOR'S OR LANDOWNER'S CERTIFICATION: This water well was Constructed under my jurisdiction and was completed on (mo/day/year) 07/13/05 and this record is true to the best of my knowledge and belief. Kansas Water Well Contractor's License No. 145 This Water Well Record was completed on (mo/day/yr) 10/13/05 under the business name of HENKLE DRILLING & SUPPLY by (signature) *Don J. Henkle*