


1 LOCATION OF WATER WELL:	Fraction County: Wichita	SW $\frac{1}{4}$	SW $\frac{1}{4}$	SW $\frac{1}{4}$	Section Number 17	Township Number T 18 S	Range Number R 36 E/W
---------------------------	-----------------------------	------------------	------------------	------------------	----------------------	---------------------------	--------------------------

Distance and direction from nearest town or city street address of well if located within city?

From Leoti, 1-1/2 E on N Side of 96 Hwy

2 WATER WELL OWNER:	ESE Alcohol RR#, St. Address, Box # : P.O. Box 813	Board of Agriculture, Division of Water Resources Application Number: 34471
City, State, ZIP Code	Leoti, KS 67861	

3 LOCATE WELL'S LOCATION WITH AN "X" IN SECTION BOX:	4 DEPTH OF COMPLETED WELL ft. ELEVATION:
--	--

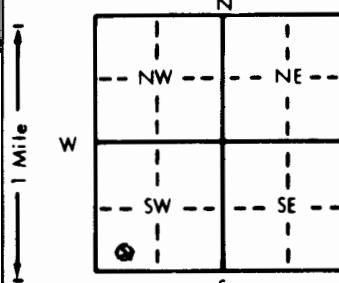

Depth(s) Groundwater Encountered 1 ft. 2 ft. 3 ft.

WELL'S STATIC WATER LEVEL .138 ft. below land surface measured on mo/day/yr

Pump test data: Well water was ft. after hours pumping gpm

Est. Yield gpm: Well water was ft. after hours pumping gpm

Bore Hole Diameter in. to ft., and in. to ft.

WELL WATER TO BE USED AS: 5 Public water supply 8 Air conditioning 11 Injection well

1 Domestic 3 Feedlot 6 Oil field water supply 9 Dewatering 12 Other (Specify below)

2 Irrigation 4 Industrial 7 Lawn and garden only 10 Monitoring well

Was a chemical/bacteriological sample submitted to Department? Yes No X; If yes, mo/day/yr sample was submitted

Water Well Disinfected? Yes X No

5 TYPE OF BLANK CASING USED:	5 Wrought iron	8 Concrete tile	CASING JOINTS: Glued Clamped
1 Steel	6 Asbestos-Cement	9 Other (specify below)	Welded
2 PVC	7 Fiberglass		Threaded

Blank casing diameter 5 $\frac{1}{2}$ in. to 150 ft., Dia in. to ft., Dia in. to ft.

Casing height above land surface 36" Below in., weight lbs./ft. Wall thickness or gauge No.

TYPE OF SCREEN OR PERFORATION MATERIAL:	7 PVC	10 Asbestos-cement
1 Steel	5 Fiberglass	11 Other (specify)
2 Brass	6 Concrete tile	12 None used (open hole)

SCREEN OR PERFORATION OPENINGS ARE:

1 Continuous slot	3 Mill slot	5 Gauzed wrapped	8 Saw cut	11 None (open hole)
2 Louvered shutter	4 Key punched	6 Wire wrapped	9 Drilled holes	
		7 Torch cut	10 Other (specify)	NA

SCREEN-PERFORATED INTERVALS: From ft. to ft., From ft. to ft.

From ft. to ft., From ft. to ft.

GRAVEL PACK INTERVALS: From ft. to ft., From ft. to ft.

From ft. to ft., From ft. to ft.

6 GROUT MATERIAL: 1 Neat cement 2 Cement grout 3 Bentonite 4 Other

Grout Intervals: From 135 ft. to 130 ft., From 13 ft. to 3 ft., From ft. to ft.

What is the nearest source of possible contamination:

1 Septic tank	4 Lateral lines	7 Pit privy	10 Livestock pens	14 Abandoned water well
2 Sewer lines	5 Cess pool	8 Sewage lagoon	11 Fuel storage	15 Oil well/Gas well
3 Watertight sewer lines	6 Seepage pit	9 Feedyard	12 Fertilizer storage	16 Other (specify below)

Direction from well?

FROM	TO	LITHOLOGIC LOG	FROM	TO	PLUGGING INTERVALS
			150	135	Chlorinated Sand
			135	130	Bentonite Plug
			130	13	Compacted Clay
			13	3	Bentonite Plug
			3	0	Top Soil

How many feet?

					Casing Cut Off 3' Below Surface
--	--	--	--	--	---------------------------------

7 CONTRACTOR'S OR LANDOWNER'S CERTIFICATION: This water well was (1) constructed, (2) reconstructed, or (3) plugged under my jurisdiction and was completed on (mo/day/year) 07/16/91 and this record is true to the best of my knowledge and belief. Kansas

Water Well Contractor's License No. 514 This Water Well Record was completed on (mo/day/yr) 07/31/91

under the business name of Miller Gearhead & Pump Repair, Inc by (signature) *Edgar Miller*

INSTRUCTIONS: Use typewriter or ball point pen. PLEASE PRESS FIRMLY and PRINT clearly. Please fill in blanks, underline or circle the correct answers. Send top three copies to Kansas Department of Health and Environment, Bureau of Water, Topeka, Kansas 66620-7320. Telephone: 913-296-5545. Send one to WATER WELL OWNER and retain one for your records.