

## WATER WELL RECORD

Form WWC-5

KSA 82a-1212


1 LOCATION OF WATER WELL:	Fraction County: Wichita	NE $\frac{1}{4}$ NE $\frac{1}{4}$ NW $\frac{1}{4}$	Section Number 19	Township Number T 18 S	Range Number R 36 EW
---------------------------	-----------------------------	--	----------------------	---------------------------	-------------------------

Distance and direction from nearest town or city street address of well if located within city?

1 Mile Southwest of Leoti

2 WATER WELL OWNER:	City of Leoti RR#, St. Address, Box # : Leoti, Kansas 67861	Board of Agriculture, Division of Water Resources Application Number:
---------------------	---	--

3 LOCATE WELL'S LOCATION WITH AN "X" IN SECTION BOX:	4 DEPTH OF COMPLETED WELL . . . . . 180 ft. ELEVATION: . . . . .
--	--

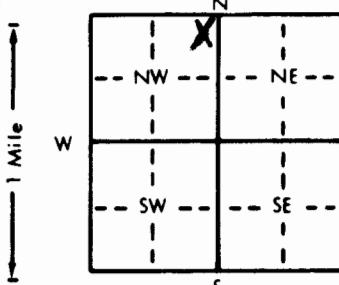

Depth(s) Groundwater Encountered 1. ft. 2. ft. 3. ft.

WELL'S STATIC WATER LEVEL . . . . . 148 ft. below land surface measured on mo/day/yr

Pump test data: Well water was . . . . . ft. after . . . . . hours pumping . . . . . gpm

Est. Yield . . . . . gpm: Well water was . . . . . ft. after . . . . . hours pumping . . . . . gpm

Bore Hole Diameter . . . . . 8 in. to . . . . . 180 ft., and . . . . . in. to . . . . . ft.

WELL WATER TO BE USED AS: 5 Public water supply 8 Air conditioning 11 Injection well

1 Domestic 3 Feedlot 6 Oil field water supply 9 Dewatering 12 Other (Specify below)

2 Irrigation 4 Industrial 7 Lawn and garden only 10 Monitoring well

Was a chemical/bacteriological sample submitted to Department? Yes . . . . . No . . . . . X If yes, mo/day/yr sample was submitted

Water Well Disinfected? Yes No X

5 TYPE OF BLANK CASING USED:	5 Wrought iron	8 Concrete tile	CASING JOINTS: Glued . . . . . Clamped . . . . .
------------------------------	----------------	-----------------	--

1 Steel 3 RMP (SR)

2 PVC 4 ABS

6 Asbestos-Cement

7 Fiberglass

9 Other (specify below)

Welded

Threaded X

Blank casing diameter . . . . . 4 in. to . . . . . 140 ft., Dia . . . . . in. to . . . . . ft., Dia . . . . . in. to . . . . . ft.

Casing height above land surface . . . . . 18 in., weight . . . . . 2.071 lbs./ft. Wall thickness or gauge No. . . . . . 237

TYPE OF SCREEN OR PERFORATION MATERIAL:

1 Steel 3 Stainless steel

2 Brass 4 Galvanized steel

5 Fiberglass

6 Concrete tile

7 PVC

8 RMP (SR)

9 ABS

10 Asbestos-cement

11 Other (specify)

12 None used (open hole)

SCREEN OR PERFORATION OPENINGS ARE:

1 Continuous slot 3 Mill slot

2 Louvered shutter 4 Key punched

5 Gauzed wrapped

6 Wire wrapped

7 Torch cut

8 Saw cut

9 Drilled holes

10 Other (specify)

11 None (open hole)

SCREEN-PERFORATED INTERVALS: From . . . . . 140 ft. to . . . . . 180 ft., From . . . . . ft. to . . . . . ft.

From . . . . . ft. to . . . . . ft., From . . . . . ft. to . . . . . ft.

GRAVEL PACK INTERVALS: From . . . . . 20 ft. to . . . . . 180 ft., From . . . . . ft. to . . . . . ft.

From . . . . . ft. to . . . . . ft., From . . . . . ft. to . . . . . ft.

6 GROUT MATERIAL: 1 Neat cement 2 Cement grout 3 Bentonite 4 Other . . . . .

Grout Intervals: From . . . . . 0 ft. to . . . . . 20 ft., From . . . . . ft. to . . . . . ft., From . . . . . ft. to . . . . . ft.

What is the nearest source of possible contamination:

1 Septic tank 4 Lateral lines

2 Sewer lines 5 Cess pool

3 Watertight sewer lines 6 Seepage pit

7 Pit privy

8 Sewage lagoon

9 Feedyard

10 Livestock pens

11 Fuel storage

12 Fertilizer storage

13 Insecticide storage

14 Abandoned water well

15 Oil well/Gas well

16 Other (specify below)

Direction from well? East How many feet? 150'

FROM TO LITHOLOGIC LOG FROM TO PLUGGING INTERVALS

0	3	Top Soil	125	140	Clay w/fine sand strks
---	---	----------	-----	-----	------------------------

3	15	Silty Clay	140	168	Fine to Med. Sand & gravel
---	----	------------	-----	-----	----------------------------

15	34	Clay	168	180	Shale
----	----	------	-----	-----	-------

34	40	Med. Hard Cemented Sand			
----	----	-------------------------	--	--	--

40	51	Med. Sand w/Hard Layers			
----	----	-------------------------	--	--	--

51	54	Hard Rock			
----	----	-----------	--	--	--

54	68	Cemented Sand w/Caliche Strks.			
----	----	--------------------------------	--	--	--

68	76	Rock w/cemented sand layers			
----	----	-----------------------------	--	--	--

76	82	Fine to Med. Sand & Gravel			
----	----	----------------------------	--	--	--

82	90	Caliche w/Clay Strks.			
----	----	-----------------------	--	--	--

90	100	Tight Brown cemented sandy Clay			
----	-----	---------------------------------	--	--	--

100	106	Sandy Clay			
-----	-----	------------	--	--	--

106	113	Fine light sand			
-----	-----	-----------------	--	--	--

113	117	Med Sand & Loose gravel			
-----	-----	-------------------------	--	--	--

117	125	Fine sand w/Clay Strks.			
-----	-----	-------------------------	--	--	--

7 CONTRACTOR'S OR LANDOWNER'S CERTIFICATION: This water well was (1) constructed, (2) reconstructed, or (3) plugged under my jurisdiction and was completed on (mo/day/year) . . . . . 4-8-93 and this record is true to the best of my knowledge and belief. Kansas

Water Well Contractor's License No. . . . . 554 This Water Well Record was completed on (mo/day/yr) . . . . . 8-19-93

under the business name of WOOFTER PUMP & WELL, INC. by (signature) *gary a. woofter*

INSTRUCTIONS: Use typewriter or ball point pen. PLEASE PRESS FIRMLY and PRINT clearly. Please fill in blanks, underline or circle the correct answers. Send top three copies to Kansas Department of Health and Environment, Bureau of Water, Topeka, Kansas 66620-0001. Telephone: 913-296-5545. Send one to WATER WELL OWNER and retain one for your records.