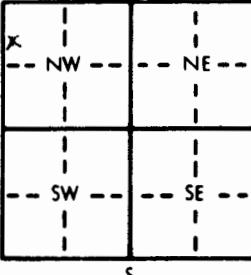
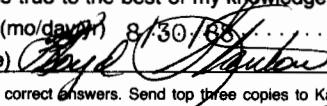


1 LOCATION OF WATER WELL:		Fraction SW $\frac{1}{4}$ NW $\frac{1}{4}$ NW $\frac{1}{4}$	Section Number 21	Township Number T 18 S	Range Number R 36 E/W
County: Wichita Distance and direction from nearest town or city street address of well if located within city?					
2 WATER WELL OWNER:		Cargill Hybrid Seeds			
RR#, St. Address, Box #:		Board of Agriculture, Division of Water Resources			
City, State, ZIP Code:		Application Number:			
3 LOCATE WELL'S LOCATION WITH AN "X" IN SECTION BOX:		4 DEPTH OF COMPLETED WELL ft. ELEVATION:			
		Depth(s) Groundwater Encountered 1. ft. 2. ft. 3. ft. WELL'S STATIC WATER LEVEL ft. below land surface measured on mo/day/yr 8/26/88 NA Pump test data: Well water was ft. after hours pumping gpm Est. Yield gpm: Well water was ft. after hours pumping gpm Bore Hole Diameter 9 in. to 168 ft. and in. to ft. WELL WATER TO BE USED AS: 5 Public water supply 8 Air conditioning 11 Injection well 1 Domestic 3 Feedlot 6 Oil field water supply 9 Dewatering 12 Other (Specify below) 2 Irrigation 4 Industrial 7 Lawn and garden only 10 Monitoring well Was a chemical/bacteriological sample submitted to Department? Yes No X If yes, mo/day/yr sample was submitted Water Well Disinfected? Yes X No			
5 TYPE OF BLANK CASING USED:		5 Wrought iron 1 Steel 2 PVC	8 Concrete tile 6 Asbestos-Cement 7 Fiberglass	CASING JOINTS: Glued Clamped Welded Threaded	
Blank casing diameter in. to ft.		Dia in. to ft. Dia in. to ft.			
Casing height above land surface in., weight lbs./ft.		Wall thickness or gauge No. 258			
TYPE OF SCREEN OR PERFORATION MATERIAL:					
1 Steel 2 Brass	3 Stainless steel 4 Galvanized steel	5 Fiberglass 6 Concrete tile	7 PVC 8 RMP (SR) 9 ABS	10 Asbestos-cement 11 Other (specify) 12 None used (open hole)	10 Asbestos-cement 11 Other (specify) 12 None used (open hole)
SCREEN OR PERFORATION OPENINGS ARE:					
1 Continuous slot 2 Louvered shutter	3 Mill slot 4 Key punched	5 Gauzed wrapped 6 Wire wrapped 7 Torch cut	8 Saw cut 9 Drilled holes 10 Other (specify)	11 None (open hole)	11 None (open hole)
SCREEN-PERFORATED INTERVALS: From 148 ft. to 168 ft., From ft. to ft.					
From ft. to ft., From ft. to ft.					
GRAVEL PACK INTERVALS: From 90 ft. to 168 ft., From ft. to ft.					
From ft. to ft., From ft. to ft.					
6 GROUT MATERIAL: 1 Neat cement 2 Cement grout 3 Bentonite 4 Other Drill cuttings					
Grout Intervals: From 25 ft. to 90 ft., From 4 ft. to 25 ft., From ft. to ft.					
What is the nearest source of possible contamination:					
1 Septic tank 2 Sewer lines 3 Watertight sewer lines	4 Lateral lines 5 Cess pool 6 Seepage pit	7 Pit privy 8 Sewage lagoon 9 Feedyard	10 Livestock pens 11 Fuel storage 12 Fertilizer storage 13 Insecticide storage	14 Abandoned water well 15 Oil well/Gas well 16 Other (specify below)	
Direction from well? Southeast How many feet? 100					
FROM	TO	LITHOLOGIC LOG	FROM	TO	PLUGGING INTERVALS
0	22	Clay	22	29	Caliche
29	35	Sandy clay	35	42	Sand cemented
42	50	Sand	50	56	Sand cemented
56	62	Caliche	62	71	Clay fine sand streaks
71	82	Fine sand	82	115	Fine sand clay streaks
115	130	Sand	130	144	Fine sand cemented streaks
144	150	Medium sand	150	164	Sand
164	167	Yellow clay	167	168	Shale
7 CONTRACTOR'S OR LANDOWNER'S CERTIFICATION: This water well was (1) constructed, (2) reconstructed, or (3) plugged under my jurisdiction and was completed on (mo/day/year) 8/29/88 and this record is true to the best of my knowledge and belief. Kansas Water Well Contractor's License No. 232 This Water Well Record was completed on (mo/day) 8/30/88 by (signature) 					
INSTRUCTIONS: Use typewriter or ball point pen. PLEASE PRESS FIRMLY and PRINT clearly. Please fill in blanks, underline or circle the correct answers. Send top three copies to Kansas Department of Health and Environment, Bureau of Water Protection, Topeka, Kansas 66620-7320. Telephone: 913-296-5514. Send one to WATER WELL OWNER and retain one for your records.					