

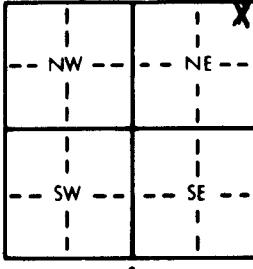
## WATER WELL RECORD Form WWC-5 KSA 82a-1212

1 LOCATION OF WATER WELL: County: Wichita	Fraction NE $\frac{1}{4}$ NE $\frac{1}{4}$ NE $\frac{1}{4}$	Section Number 23	Township Number T 18 S	Range Number R 36 E/W
--	--	----------------------	---------------------------	--------------------------

Distance and direction from nearest town or city street address of well if located within city?

3  $\frac{1}{4}$  miles west of Marienthal, KS

2 WATER WELL OWNER: Wesley Nelson

RR#, St. Address, Box #: Rt 1 Box 6  
City, State, ZIP Code : Leoti, KS 67861Board of Agriculture, Division of Water Resources  
Application Number:3 LOCATE WELL'S LOCATION WITH AN "X" IN SECTION BOX:  
N  E  
W S

4 DEPTH OF COMPLETED WELL... 163 ft. ELEVATION: 3240

Depth(s) Groundwater Encountered 1. 108 ft. 2. ft. 3. ft.

WELL'S STATIC WATER LEVEL 108 ft. below land surface measured on mo/day/yr 8-29-91

Pump test data: Well water was 130 ft. after 2 hours pumping 20 gpm

Est. Yield 30 gpm: Well water was ft. after hours pumping gpm

Bore Hole Diameter 8 in. to 163 ft. and in. to ft.

WELL WATER TO BE USED AS: 5 Public water supply 8 Air conditioning 11 Injection well

1 Domestic 3 Feedlot 6 Oil field water supply 9 Dewatering 12 Other (Specify below)

2 Irrigation 4 Industrial 7 Lawn and garden only 10 Monitoring well

Was a chemical/bacteriological sample submitted to Department? Yes  No  If yes, mo/day/yr sample was submittedWater Well Disinfected? Yes  No 5 TYPE OF BLANK CASING USED: 5 Wrought iron 8 Concrete tile Casing joints: Glued  Clamped 1 Steel 3 RMP (SR) 6 Asbestos-Cement 9 Other (specify below) Welded 2 PVC 4 ABS 7 Fiberglass Threaded 

Blank casing diameter 5 in. to 143 ft. Dia in. to ft. Dia in. to ft.

Casing height above land surface 12 in. weight lbs./ft. Wall thickness or gauge No. Sch 40

TYPE OF SCREEN OR PERFORATION MATERIAL: 7 PVC 10 Asbestos-cement

1 Steel 3 Stainless steel 5 Fiberglass 8 RMP (SR) 11 Other (specify) 2 Brass 4 Galvanized steel 6 Concrete tile 9 ABS 12 None used (open hole) 

SCREEN OR PERFORATION OPENINGS ARE: 5 Gauzed wrapped 8 Saw cut 11 None (open hole)

1 Continuous slot 3 Mill slot 6 Wire wrapped 9 Drilled holes 2 Louvered shutter 4 Key punched 7 Torch cut 10 Other (specify) 

SCREEN-PERFORATED INTERVALS: From 143 ft. to 163 ft. From ft. to ft.

From ft. to ft. From ft. to ft.

GRAVEL PACK INTERVALS: From 88 25 ft. to 163 ft. From ft. to ft.

From ft. to ft. From ft. to ft.

6 GROUT MATERIAL: 1 Neat cement 2 Cement grout 3 Bentonite 4 Other 

Grout Intervals: From 5 ft. to 25 ft. From ft. to ft. From ft. to ft.

What is the nearest source of possible contamination: 10 Livestock pens 14 Abandoned water well

1 Septic tank 4 Lateral lines 7 Pit privy 11 Fuel storage 15 Oil well/Gas well

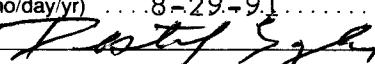
2 Sewer lines 5 Cess pool 8 Sewage lagoon 12 Fertilizer storage 16 Other (specify below)

3 Watertight sewer lines 6 Seepage pit 9 Feedyard 13 Insecticide storage 

Direction from well? south How many feet? 300

FROM	TO	LITHOLOGIC LOG	FROM	TO	PLUGGING INTERVALS
0	16	top soil & limestone			
16	28	limestone			
28	33	sand (fine)			
33	49	XX cemented sand & 2' clay (hard)			
49	61	limestone (hard)			
61	66	sandy clay			
66	82	sandy clay & little limestone			
82	109	sandy clay			
109	111	clay			
111	127	sand			
127	136	XXXX clay			
136	148	sand & gravel & 2' clay @' cemented sand			
148	153	sand			
153	159	sandy clay			
159	163	shale			

7 CONTRACTOR'S OR LANDOWNER'S CERTIFICATION: This water well was (1) constructed, (2) reconstructed, or (3) plugged under my jurisdiction and was completed on (mo/day/year) 8-29-91 and this record is true to the best of my knowledge and belief. Kansas

Water Well Contractor's License No. 473 This Water Well Record was completed on (mo/day/yr) 8-29-91  
under the business name of Tyler Water Well Service by (signature) 

INSTRUCTIONS: Use typewriter or ball point pen. PLEASE PRESS FIRMLY and PRINT clearly. Please fill in blanks, underline or circle the correct answers. Send top three copies to Kansas Department of Health and Environment, Bureau of Water, Topeka, Kansas 66620-7320. Telephone: 913-296-5545. Send one to WATER WELL OWNER and retain one for your records.

L100071006-22