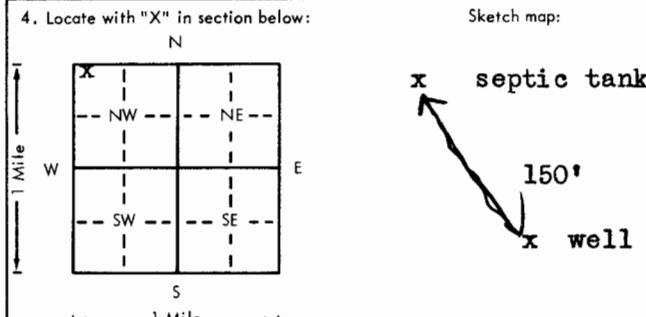
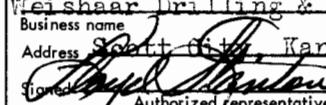


USE TYPEWRITER OR BALL
POINT PEN-PRESS FIRMLY,
PRINT CLEARLY.

WATER WELL RECORD
KSA 82a-1201-1215

Kansas Department of Health and
Environment-Division of Environment
(Water well Contractors)
Topeka, Kansas 66620

1. Location of well:	County Wichita	Fraction NW 1/4 NW 1/4 NW 1/4	Section number 25	Township number T 18	Range number S R 36	H/W
2. Distance and direction from nearest town or city: 2 1/2 Miles west 1 South of Marienthal Kans.	3. Owner of well: JIM McRAE					
Street address of well location if in city:	City, state, zip code: Leoti, Kansas 67861					
4. Locate with "X" in section below: 	Sketch map: 					
5. Type and color of material	From	To	6. Bore hole dia. <u>9</u> in. Completion date <u>4/21/79</u> Well depth <u>126</u> ft.			
Clay	0	28	7. <input type="checkbox"/> Cable tool <input checked="" type="checkbox"/> Rotary <input type="checkbox"/> Driven <input type="checkbox"/> Dug <input type="checkbox"/> Hollow rod <input type="checkbox"/> Jetted <input type="checkbox"/> Bored <input type="checkbox"/> Reverse rotary			
Sand	28	48	8. Use: <input checked="" type="checkbox"/> Domestic <input type="checkbox"/> Public supply <input type="checkbox"/> Industry <input type="checkbox"/> Irrigation <input type="checkbox"/> Air conditioning <input type="checkbox"/> Stock <input type="checkbox"/> Lawn <input type="checkbox"/> Oil field water <input type="checkbox"/> Other			
Fine sand with clay streaks	48	60	9. Casing: Material Plastic Length: Above or below Threaded <input type="checkbox"/> Welded glue Surface 12 in. RMP <input checked="" type="checkbox"/> PVC <input type="checkbox"/> Weight 1.8 lbs./ft. Dia 10.5 in. to 106 ft. depth Wall Thickness: inches or Dia. <input type="checkbox"/> in. to <input type="checkbox"/> ft. depth gage No. 250			
Rock	60	69	10. Screen: Manufacturer's name Jess & Lowell Type RMP Dia. 5" Slot/gauze 1/16 Length 20' Set between 106 ft. and 126 ft. ft. and <input type="checkbox"/> ft. Gravel pack? yes Size range of material 1/4X1/8			
Fine sand	69	105	11. Static water level: 70 ft. below land surface Date 4/20/79			
Sand	105	123	12. Pumping level below land surfaces: 80 ft. after 4 hrs. pumping 10 g.p.m. <input type="checkbox"/> ft. after <input type="checkbox"/> hrs. pumping <input type="checkbox"/> g.p.m. Estimated maximum yield 50 g.p.m.			
Yellow clay	123	126	13. Water sample submitted: no day/yr. Yes <input type="checkbox"/> No <input checked="" type="checkbox"/> Date <input type="checkbox"/>			
			14. Well head completion: <input checked="" type="checkbox"/> Pitless adapter 12 Inches above grade			
			15. Well grouted? yes With: <input checked="" type="checkbox"/> Neat cement <input type="checkbox"/> Bentonite <input type="checkbox"/> Concrete Depth: From 0 ft. to 15 ft.			
			16. Nearest source of possible contamination: ft. 150 Direction NW Type Septic Well disinfected upon completion? <input type="checkbox"/> Yes <input type="checkbox"/> No			
			17. Pump: Not installed Manufacturer's name Goulds Model number 10EJ07412P 3/4 Volts 230 Length of drop pipe 120 ft. capacity 10 g.p.m. Type: <input checked="" type="checkbox"/> Submersible <input type="checkbox"/> Turbine <input type="checkbox"/> Jet <input type="checkbox"/> Reciprocating <input type="checkbox"/> Centrifugal <input type="checkbox"/> Other			
(Use a second sheet if needed)						
18. Elevation:	19. Remarks:					
Topography: <input type="checkbox"/> Hill <input type="checkbox"/> Slope <input checked="" type="checkbox"/> Upland <input type="checkbox"/> Valley						
20. Water well contractor's certification: This well was drilled under my jurisdiction and this report is true to the best of my knowledge and belief. Weishaar Drilling & Sup. 232 Business name <input type="checkbox"/> License No. <input type="checkbox"/> Address Scott City, Kans. 67871 Signed  Date 5/2/79 Authorized representative <input type="checkbox"/>						