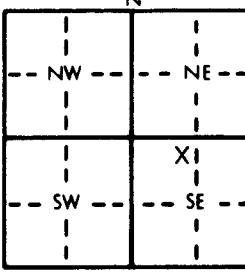
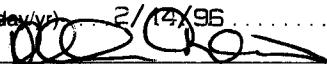


1 LOCATION OF WATER WELL:		Fraction County: Wichita Distance and direction from nearest town or city street address of well if located within city?	Section Number NE $\frac{1}{4}$ NW $\frac{1}{4}$ SE $\frac{1}{4}$ 13 Southwest corner of 'C' st. and 7th	Township Number T 18 S Range Number R 37 E <u>W</u>			
2 WATER WELL OWNER: Environmental Protection Agency RR#, St. Address, Box # 726 Minnesota City, State, ZIP Code Kansas City, Kansas 66101		Board of Agriculture, Division of Water Resources Application Number:					
3 LOCATE WELL'S LOCATION WITH AN "X" IN SECTION BOX: 		4 DEPTH OF COMPLETED WELL 177.8 ft. ELEVATION: Depth(s) Groundwater Encountered 1. ft. 2. ft. 3. ft. WELL'S STATIC WATER LEVEL ft. below land surface measured on mo/day/yr Pump test data: Well water was ft. after hours pumping gpm Est. Yield gpm: Well water was ft. after hours pumping gpm Bore Hole Diameter 7.7/8 in. to ft. and in. to ft. WELL WATER TO BE USED AS: 5 Public water supply 8 Air conditioning 11 Injection well 1 Domestic 3 Feedlot 6 Oil field water supply 9 Dewatering 12 Other (Specify below) 2 Irrigation 4 Industrial 7 Lawn and garden only 10 Monitoring well Was a chemical/bacteriological sample submitted to Department? Yes No XX If yes, mo/day/yr sample was submitted Water Well Disinfected? Yes No					
5 TYPE OF BLANK CASING USED: 1 Steel 3 RMP (SR) 2 PVC 4 ABS		5 Wrought iron 6 Asbestos-Cement 7 Fiberglass	8 Concrete tile 9 Other (specify below)	CASING JOINTS: Glued Clamped Welded Threaded. XX			
Blank casing diameter 2 in. to 155 ft., Dia in. to ft., Dia in. to ft.		lbs./ft. Wall thickness or gauge No. SCH. 40					
Casing height above land surface 24 in., weight TYPE OF SCREEN OR PERFORATION MATERIAL: 1 Steel 3 Stainless steel 5 Fiberglass 7 PVC 10 Asbestos-cement 2 Brass 4 Galvanized steel 6 Concrete tile 9 ABS 11 Other (specify) 12 None used (open hole)							
SCREEN OR PERFORATION OPENINGS ARE: 1 Continuous slot 3 Mill slot 5 Gauzed wrapped 8 Saw cut 11 None (open hole) 2 Louvered shutter 4 Key punched 6 Wire wrapped 9 Drilled holes 7 Torch cut 10 Other (specify) SCREEN-PERFORATED INTERVALS: From 155 ft. to 175 ft., From ft. to ft.							
GRAVEL PACK INTERVALS: From 150 ft. to 178 ft., From ft. to ft., From ft. to ft.							
6 GROUT MATERIAL: 1 Neat cement 2 Cement grout 3 Bentonite 4 Other Cement & Bentonite							
Grout Intervals: From 00 ft. to 143 ft., From ft. to ft., From ft. to ft.							
What is the nearest source of possible contamination: 1 Septic tank 4 Lateral lines 7 Pit privy 10 Livestock pens 14 Abandoned water well 2 Sewer lines 5 Cess pool 8 Sewage lagoon 11 Fuel storage 15 Oil well/Gas well 3 Watertight sewer lines 6 Seepage pit 9 Feedyard 12 Fertilizer storage 16 Other (specify below) 13 Insecticide storage							
Direction from well?		How many feet?					
FROM	TO	LITHOLOGIC LOG		FROM	TO	PLUGGING INTERVALS	
00	20	Overburden Soil					
20	40	Silt Trace Sand					
40	85	Sand & Silt					
85	91	Caliche					
91	115	Sand Silt					
115	125	Sand Gravel					
125	144	Sand Gravel					
144	154	Caliche Sand					
154	174	Sand & Gravel					
174	176	Shale					
7 CONTRACTOR'S OR LANDOWNER'S CERTIFICATION: This water well was (1) constructed, (2) reconstructed, or (3) plugged under my jurisdiction and was completed on (mo/day/year) 12/10/95 and this record is true to the best of my knowledge and belief. Kansas Water Well Contractor's License No. 549 This Water Well Record was completed on (mo/day/year) 2/14/96 under the business name of J & R Drilling Services, Inc.		by (signature) 					

INSTRUCTIONS: Use typewriter or ball point pen. PLEASE PRESS FIRMLY and PRINT clearly. Please fill in blanks, underline or circle the correct answers. Send top three copies to Kansas Department of Health and Environment, Bureau of Water, Topeka, Kansas 66620-0001. Telephone: 913-296-5545. Send one to WATER WELL OWNER and retain one for your records.