

Fraction

SE $\frac{1}{4}$ NE $\frac{1}{4}$ SW $\frac{1}{4}$ NW $\frac{1}{4}$

Section Number

13

Township Number

T

18

S

Range Number

R

37

EW

1 LOCATION OF WATER WELL:

County: Wichita

Fraction

SE $\frac{1}{4}$ NE $\frac{1}{4}$ SW $\frac{1}{4}$ NW $\frac{1}{4}$

Section Number

13

Township Number

T

18

S

Range Number

R

37

EW

Distance and direction from nearest town or city street address of well if located within city?

Southwest of the intersection of 'F' St. and 4th

2 WATER WELL OWNER:

Environmental Protection Agency


Board of Agriculture, Division of Water Resources

RR#, St. Address, Box # : 726 Minnesota

Application Number:

City, State, ZIP Code : Kansas City, Kansas 66101

3 LOCATE WELL'S LOCATION WITH AN "X" IN SECTION BOX:

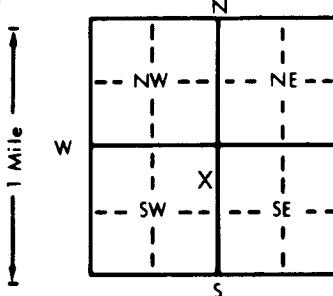

4 DEPTH OF COMPLETED WELL.....173 ft. ELEVATION:

Depth(s) Groundwater Encountered 1.....ft. 2.....ft. 3.....ft.

WELL'S STATIC WATER LEVELft. below land surface measured on mo/day/yr

Pump test data: Well water wasft. afterhours pumpinggpm

Est. Yieldgpm: Well water wasft. afterhours pumpinggpm

Bore Hole Diameter 7.7/8 in. toft., andin. toft.

WELL WATER TO BE USED AS: 5 Public water supply 8 Air conditioning 11 Injection well

1 Domestic 3 Feedlot 6 Oil field water supply 9 Dewatering 12 Other (Specify below)

2 Irrigation 4 Industrial 7 Lawn and garden only 10 Monitoring well

Was a chemical/bacteriological sample submitted to Department? Yes.....No.....If yes, mo/day/yr sample was submitted

Water Well Disinfected? Yes No

5 TYPE OF BLANK CASING USED:

1 Steel 3 RMP (SR)

5 Wrought iron

8 Concrete tile

CASING JOINTS: GluedClamped

2 PVC 4 ABS

6 Asbestos-Cement

9 Other (specify below)

Welded

7 Fiberglass

Threaded. XX

Blank casing diameter2 in. to 173.9 ft., Diain. toft., Diain. toft.

Casing height above land surface30 in., weightlbs./ft. Wall thickness or gauge No. SCH. 40

TYPE OF SCREEN OR PERFORATION MATERIAL:

1 Steel 3 Stainless steel

5 Fiberglass

7 PVC

10 Asbestos-cement

2 Brass 4 Galvanized steel

6 Concrete tile

8 RMP (SR)

11 Other (specify)

9 ABS

12 None used (open hole)

SCREEN OR PERFORATION OPENINGS ARE:

1 Continuous slot 3 Mill slot

5 Gauzed wrapped

8 Saw cut

11 None (open hole)

6 Wire wrapped

9 Drilled holes

2 Louvered shutter 4 Key punched

7 Torch cut

10 Other (specify)

SCREEN-PERFORATED INTERVALS: From151.7 ft. to171.8 ft., Fromft. toft.

Fromft. toft., Fromft. toft.

GRAVEL PACK INTERVALS: From145 ft. to176 ft., Fromft. toft.

Fromft. toft., Fromft. toft.

6 GROUT MATERIAL: 1 Neat cement 2 Cement grout 3 Bentonite 4 Other

Grout Intervals: From00 ft. to138 ft., Fromft. toft., Fromft. toft.

What is the nearest source of possible contamination:

1 Septic tank 4 Lateral lines

7 Pit privy

10 Livestock pens

14 Abandoned water well

2 Sewer lines 5 Cess pool

8 Sewage lagoon

11 Fuel storage

15 Oil well/Gas well

3 Watertight sewer lines 6 Seepage pit

9 Feedyard

12 Fertilizer storage

16 Other (specify below)

13 Insecticide storage

Direction from well?

How many feet?

FROM	TO	LITHOLOGIC LOG	FROM	TO	PLUGGING INTERVALS
00	20	Overburden Soil			
20	40	Sand & Silt			
40	45	Lost Circulation			
45	46	Hard Caliche			
46	70	Sand Gravel			
70	71	Gray Silt - Caliche			
71	84	Sand Gravel - Some Silt			
84	91	Caliche			
91	130	Sand & Gravel			
130	170	Gravel Sand Trace Silt			
170	174	Yellow Silt to Clay			
174	175	Black Shale			

7 CONTRACTOR'S OR LANDOWNER'S CERTIFICATION: This water well was (1) constructed, (2) reconstructed, or (3) plugged under my jurisdiction and was completed on (mo/day/year) 12/12/95. and this record is true to the best of my knowledge and belief. Kansas

Water Well Contractor's License No. 549. This Water Well Record was completed on (mo/day/year) 14/96. under the business name of J & R Drilling Services, Inc. by (signature) 