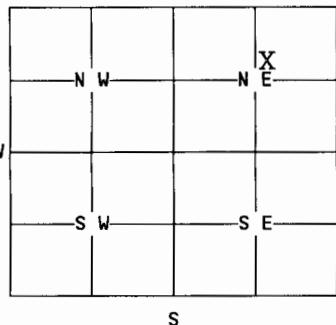


1	LOCATION OF WATER WELL:	Fraction	Section Number	Township Number	Range Number												
County: Wichita		SW 1/4NE 1/4NE 1/4	19	18	37												
Distance and direction from nearest town or city street address of well if located within city? 4 1/2 W 1/4S 1/4 W of Leoti, KS																	
2	WATER WELL OWNER: L & R, Inc.	RR#, St. Address, Box #: c/o Ralph Reitz City, State, ZIP Code : PO Box 86 Lawrence, KS 66044	Board of Agriculture, Division of Water Resources Application Number:														
3	MARK WELL'S LOCATION WITH AN "X" IN SECTION BOX: N	4 DEPTH OF WELL.....166.....ft. WELL'S STATIC WATER LEVEL.....148.....ft. WELL WAS USED AS:															
		<table> <tr><td>1 Domestic</td><td>5 Public Water Supply</td><td>9 Dewatering</td></tr> <tr><td>2 Irrigation</td><td>6 Oil Field Water Supply</td><td>10 Monitoring Well</td></tr> <tr><td>3 Feedlot</td><td>7 Lawn and Garden Only</td><td>11 Injection Well</td></tr> <tr><td>4 Industrial</td><td>8 Air Conditioning</td><td>12 Other.....</td></tr>
		Was a chemical/bacteriological sample submitted to Department? Yes....No.X.. If yes, mo/day/yr sample was submitted.....															
		Water Well Disinfected: Yes.X.... No.....															
5	TYPE OF BLANK CASING USED:																
	1 Steel 2 PVC	3 RMP (SR) 4 ABS	5 Wrought 6 Asbestos-Cement	7 Fiberglass 8 Concrete Tile	9 Other (specify below)												
	Blank casing diameter....16....in. Was casing pulled? Yes..... No.X.... If yes, how much..... Casing height above or <u>below</u> land surface.....36.....in.																
6	GROUT PLUG MATERIAL: 1 Neat cement    2 Cement grout    3 Bentonite    4 Other.....																
	Grout Plug Intervals: From.....ft. to.....ft., From.....ft. to .....ft., From..... to.....ft.																
	What is the nearest source of possible contamination:																
	1 Septic tank 2 Sewer lines 3 Watertight sewer lines 4 Lateral lines 5 Cess Pool	6 Seepage pit 7 Pit privy 8 Sewage lagoon 9 Feedyard 10 Livestock pens	11 Fuel storage 12 Fertilizer storage 13 Insecticide storage 14 Abandoned water well 15 Oil well/Gas well	16 Other (specify below)													
	Direction from well? ..... How many feet? .....																
	FROM	TO	PLUGGING MATERIALS														
	166	30	Fill Sand														
	30	6	Dirt														
	6	3	Bentonite														
	3	0	Top Soil														
7	CONTRACTOR'S OR LANDOWNER'S CERTIFICATION: This water well was plugged under my jurisdiction and was completed on (mo/day/year)....9/17/04..... and this record is true to the best of my knowledge and belief. Kansas Water Well Contractor's License No. ....554..... This Water Well Record was completed on (mo/day/year) ....9/24/04..... under the business name of ..Woofter Pump & Well..INC.. by (signature) .... <i>Tom Ballar</i> .....																
	INSTRUCTIONS: Use typewriter or ball point pen. Please press firmly and print clearly. Please fill in blanks, underline or circle the correct answers. Send top three copies to Kansas Department of Health and Environment, Bureau of Water, Topeka, Kansas 66620-0001. Telephone: 913/296-3565. Send one to Water Well Owner and retain one for your records.																

REC'D

SEP 29 2004

EJL