

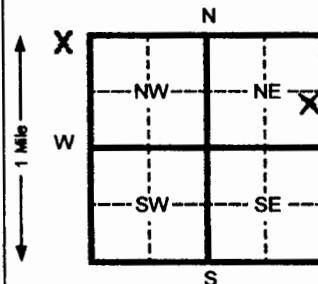
1 LOCATION OF WATER WELL: County: Wichita	Fraction NE 1/4 SE 1/4 NE 1/4	Section Number 23	Township Number T 18 S	Range Number R 37 E
---	---	-----------------------------	----------------------------------	-------------------------------

Distance and direction from nearest town or city street address of well if located within city?

2 WATER WELL OWNER: **Lonnie Bush**RR#, St. Address, Box #: **PO Box 309**City, State, ZIP Code: **Leoti, KS 67861**

Board of Agriculture, Division of Water Resources

Application Number:

3 LOCATE WELL'S LOCATON WITH
AN "X" IN SECTION BOX:4 DEPTH OF COMPLETED WELL **165** ft. ELEVATION:Depth(s) Groundwater Encountered **1** ft. 2 ft. 3 ft.WELL'S STATIC WATER LEVEL **na** ft. below land surface measured on mo/day/yr

Pump test data: Well water was ft. after hours pumping gpm

Est. Yield gpm: Well water was ft. after hours pumping gpm

Bore Hole Diameter **8** in. to **180** ft. and in. to ft.WELL WATER TO BE USED AS: **5** Public water supply **8** Air conditioning **11** Injection well

1 Domestic 3 Feed lot 6 Oil field water supply 9 Dewatering 12 Other (Specify below)

2 Irrigation 4 Industrial 7 Lawn and garden (domestic) 10 Monitoring well

Was a chemical/bacteriological sample submitted to Department? Yes **No X** If yes, mo/day/yr sample was submittedWater Well Disinfected? Yes **X** No

5 TYPE OF BLANK CASING USED:

1 Steel **3 RMP (SR)**
2 PVC 4 ABS

5 Wrought Iron

8 Concrete tile

CASING JOINTS: Glued _____ Clamped _____

6 Asbestos-Cement

9 Other (specify below)

Welded _____

7 Fiberglass

Threaded _____

Blank casing diameter **4.5**in. to **125** ft. Dia in. to ft. Dia in. to ft.Casing height above land surface **18** in. weight **2.38** lbs./ft. Wall thickness or gauge No. **.248**

TYPE OF SCREEN OR PERFORATION MATERIAL:

1 Steel **3 Stainless steel**
2 Brass **4 Galvanized steel**

5 Fiberglass

7 PVC

10 Asbestos-cement

6 Concrete tile

8 RMP (SR)

11 Other (specify)

5 Gauzed wrapped

9 ABS

12 None used (open hole)

6 Wire wrapped

10 Other (specify)

7 Torch cut

11 None (open hole)

SCREEN OR PERFORATION OPENINGS ARE:

1 Continuous slot **3 Mill slot**
2 Louvered shutter **4 Key punched**

8 Saw cut

9 Drilled holes

SCREEN-PERFORATED INTERVALS: From **125** ft. to **165** ft. From ft. to ft. From ft. to ft.

From ft. to ft. From ft. to ft.

GRAVEL PACK INTERVALS: From **20** ft. to **165** ft. From ft. to ft. From ft. to ft.

From ft. to ft. From ft. to ft.

6 GROUT MATERIAL: 1 Neat cement 2 Cement grout 3 Bentonite 4 Other

Grout Intervals From ft. to ft. From ft. to ft. From ft. to ft.

What is the nearest source of possible contamination:

1 Septic tank **4 Lateral lines**
2 Sewer lines **5 Cess pool**
3 Watertight sewer lines **6 Seepage pit**
7 Pit privy **10 Livestock pens**
8 Sewage lagoon **11 Fuel storage**
9 Feedyard **12 Fertilizer storage**
13 Insecticide storage **14 Abandoned water well**
15 Oil well/ Gas well
16 Other (specify below)
none

Direction from well?

How many feet?

FROM	TO	CODE	LITHOLOGIC LOG	FROM	TO	PLUGGING INTERVALS
0	2		Surface	126	140	Fine to some med sd w/clay & Caliche lens
2	7		Loess			
7	12		Clay	140	144	Clay
12	16		Clay & caliche	144	146	Clay w/sand strk
16	21		Cemented sand & sand strk	146	157	Fine to some med sand w/clay strks
21	28		Clay & caliche	157	166	Yellow ochre
28	32		Med sand w/clay strk	166	180	Black shale
32	60		Caliche & cemented sand			
60	81		Clay & caliche			
81	92		Fine to some med sand w/clay & caliche strk			
92	108		Clay			
108	115		Sandstone			
115	126		Fine sand w/sandy clay strk			

7 CONTRACTOR'S OR LANDOWNER'S CERTIFICATION: This water well was (1) constructed, (2) reconstructed, or (3) plugged under my jurisdiction and was completed on (mo/day/yr) **5-3-05** and this record is true to the best of my knowledge and belief. KansasWater Well Contractor's License No. **554** This Water Well Record was completed on (mo/day/yr) **5-20-05**under the business name of **Woofter Pump & Well Inc.** by (signature) *John E. Woofter*

INSTRUCTIONS: Please fill in blanks and circle the correct answers. Send three copies to Kansas Department of Health and Environment, Bureau of Water, 1000 S.W. Jackson St., Ste. 420, Topeka, Kansas 66612-1367. Telephone: 913-298-5545. Send one to WATER WELL OWNER and retain one for your records.