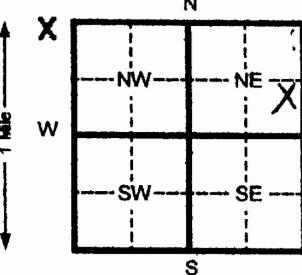
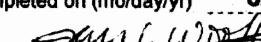


1 LOCATION OF WATER WELL:		Fraction NE 1/4 SE 1/4 NE 1/4		Section Number 23	Township Number T 18 S	Range Number R 37 E
Distance and direction from nearest town or city street address of well if located within city?						
2 WATER WELL OWNER: Lonnie Bush						
RR#, St. Address, Box # P.O. Box 509			Board of Agriculture, Division of Water Resources			
City, State, ZIP Code Leoti, Ks. 67861			Application Number:			
3 LOCATE WELL'S LOCATON WITH AN "X" IN SECTION BOX:						
		4 DEPTH OF COMPLETED WELL 165 ft. ELEVATION: 165 Depth(s) Groundwater Encountered 1 ft. 2 ft. 3 ft. WELL'S STATIC WATER LEVEL 131 ft. below land surface measured on mo/day/yr Pump test data: Well water was ft. after hours pumping gpm Est. Yield gpm: Well water was ft. after hours pumping gpm Bore Hole Diameter 8 in. to 175 ft. and in. to ft. WELL WATER TO BE USED AS: 5 Public water supply 8 Air conditioning 11 Injection well 1 Domestic 3 Feed lot 6 Oil field water supply 9 Dewatering 12 Other (Specify below) 2 Irrigation 4 Industrial 7 Lawn and garden (domestic) 10 Monitoring well Was a chemical/bacteriological sample submitted to Department? Yes <input checked="" type="checkbox"/> No <input type="checkbox"/> If yes, mo/day/yr sample was submitted Water Well Disinfected? Yes <input checked="" type="checkbox"/> No				
5 TYPE OF BLANK CASING USED:						
1 Steel 3 RMP (SR)		5 Wrought Iron 8 Concrete tile		CASING JOINTS: Glued <input checked="" type="checkbox"/> Clamped		
2 PVC 4 ABS		6 Asbestos-Cement 9 Other (specify below)		Welded		
Blank casing diameter 4.5 in. to 125		7 Fiberglass		Threaded		
Casing height above land surface 18 in., weight 2.38				in. to	ft., Dia	in. to ft.
6 TYPE OF SCREEN OR PERFORATION MATERIAL:						
1 Steel 3 Stainless steel		5 Fiberglass 8 RMP (SR)		10 Asbestos-cement		
2 Brass 4 Galvanized steel		6 Concrete tile 9 ABS		11 Other (specify)		
SCREEN OR PERFORATION OPENINGS ARE:		5 Gauzed wrapped 7 PVC		12 None used (open hole)		
1 Continuous slot 3 Mill slot		6 Wire wrapped 8 Saw cut		11 None (open hole)		
2 Louvered shutter 4 Key punched		7 Torch cut		9 Drilled holes		
SCREEN-PERFORATED INTERVALS: From 125 ft. to 165				10 Other (specify)		
GRAVEL PACK INTERVALS: From 20 ft. to 165						
From 20 ft. to 165						
7 GROUT MATERIAL: 1 Neat cement 2 Cement grout 3 Bentonite 4 Other						
Grout Intervals From 0 ft. to 20 ft. From		ft. to		ft. From	ft. From	ft. to
What is the nearest source of possible contamination:						
1 Septic tank 4 Lateral lines		7 Pit privy 10 Livestock pens		14 Abandoned water well		
2 Sewer lines 5 Cess pool		8 Sewage lagoon 11 Fuel storage		15 Oil well/ Gas well		
3 Watertight sewer lines 6 Seepage pit		9 Feedyard 12 Fertilizer storage		16 Other (specify below)		
Direction from well? How many feet?						
FROM	TO	CODE	LITHOLOGIC LOG	FROM	TO	PLUGGING INTERVALS
0	2		Surface	116	123	Clay
2	12		Loess	123	129	Fine sand w/caliche lens
12	20		caliche	129	137	Fine to some med sand
20	28		Clay & caliche	137	155	Clay
28	34		Fine to med sand	155	164	Yellow ochre
34	53		Caliche & sandstone	164	175	Black shale
53	59		Clay & caliche w/few sand str			
59	69		Cemented sand			
69	73		Clay & caliche			
73	85		Sandstone			
85	95		Fine- some med sand w/clay str			
95	104		Clay & caliche			
104	110		Clay & fine sand			
110	116		Fine sand w/clay str			
7 CONTRACTOR'S OR LANDOWNER'S CERTIFICATION: This water well was (1) constructed, (2) reconstructed, or (3) plugged under my jurisdiction and was completed on (mo/day/yr) 6/29/05 and this record is true to the best of my knowledge and belief. Kansas						
Water Well Contractor's License No. 554 This Water Well Record was completed on (mo/day/yr) 8/2/05						
under the business name of Woofter Pump & Well Inc. by (signature) 						
INSTRUCTIONS: Please fill in blanks and circle the correct answers. Send three copies to Kansas Department of Health and Environment, Bureau of Water, 1000 S W Jackson St., Ste. 420, Topeka, Kansas 66612-1367. Telephone: 913-296-5545. Send one to WATER WELL OWNER and retain one for your records.						