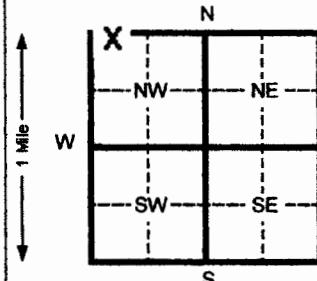


1 LOCATION OF WATER WELL: County: Wichita	Fraction NW 1/4 NW 1/4 NW 1/4	Section Number 22	Township Number T 18 S	Range Number R 37 E
---	---	-----------------------------	----------------------------------	-------------------------------

Distance and direction from nearest town or city street address of well if located within city?

2 WATER WELL OWNER: **J. Charles Jaeger**RR#, St. Address, Box #: **Box 347, 606 Country Heights**
City, State, ZIP Code: **Lakin, Ks 67860**Board of Agriculture, Division of Water Resources
Application Number: **2655**3 LOCATE WELL'S LOCATON WITH
AN "X" IN SECTION BOX:4 DEPTH OF COMPLETED WELL **200** ft. ELEVATION: _____Depth(s) Groundwater Encountered **1** ft. 2 ft. 3 ft.

WELL'S STATIC WATER LEVEL ft. below land surface measured on mo/day/yr

Pump test data: Well water was ft. after hours pumping gpm

Est. Yield gpm: Well water was ft. after hours pumping gpm

Bore Hole Diameter **18** in. to **200** ft. and in. to ft.

WELL WATER TO BE USED AS: 5 Public water supply 8 Air conditioning 11 Injection well

1 Domestic 3 Feed lot 6 Oil field water supply 9 Dewatering 12 Other (Specify below)

2 Irrigation 4 Industrial 7 Lawn and garden (domestic) 10 Monitoring well

Was a chemical/bacteriological sample submitted to Department? Yes **No X** If yes, mo/day/yr sample was submitted Water Well Disinfected? Yes **X** No

5 TYPE OF BLANK CASING USED:

1 Steel 3 RMP (SR)
2 PVC 4 ABS

5 Wrought Iron 8 Concrete tile

CASING JOINTS: Glued **X** Clamped

6 Asbestos-Cement 9 Other (specify below)

Welded

7 Fiberglass

Threaded

Blank casing diameter **10** in. to **160** ft., Dia in. to ft., Dia in. to ft.Casing height above land surface **24** in., weight **7.80** lbs./ft. Wall thickness or gauge No. **.365**

TYPE OF SCREEN OR PERFORATION MATERIAL:

1 Steel 3 Stainless steel 5 Fiberglass 10 Asbestos-cement
2 Brass 4 Galvanized steel 6 Concrete tile 9 ABS

7 PVC 10 Asbestos-cement

8 RMP (SR) 11 Other (specify)
9 ABS 12 None used (open hole)

SCREEN OR PERFORATION OPENINGS ARE:

1 Continuous slot 3 Mill slot 5 Gauzed wrapped 10 Saw cut 11 None (open hole)
2 Louvered shutter 4 Key punched 6 Wire wrapped 7 Torch cut8 Saw cut 9 Drilled holes
10 Other (specify)SCREEN-PERFORATED INTERVALS: From **160** ft. to **200** ft. From _____ ft. to _____ ft.

From _____ ft. to _____ ft. From _____ ft. to _____ ft.

GRAVEL PACK INTERVALS: From **20** ft. to **200** ft. From _____ ft. to _____ ft.

From _____ ft. to _____ ft. From _____ ft. to _____ ft.

6 GROUT MATERIAL: 1 Neat cement 2 Cement grout 3 Bentonite 4 Other

Grout Intervals From **0** ft. to **20** ft. From _____ ft. to _____ ft. From _____ ft. to _____ ft.

What is the nearest source of possible contamination:

1 Septic tank 4 Lateral lines 7 Pit privy 10 Livestock pens 14 Abandoned water well
2 Sewer lines 5 Cess pool 8 Sewage lagoon 11 Fuel storage 15 Oil well/ Gas well
3 Watertight sewer lines 6 Seepage pit 9 Feedyard 12 Fertilizer storage 16 Other (specify below)
none

Direction from well?

How many feet?

FROM	TO	CODE	LITHOLOGIC LOG	FROM	TO	PLUGGING INTERVALS
0	2		Surface	160	180	Fine to med sd w/clay lenses (slightly Loose)
2	14		Loess			
14	24		Clay	180	194	Med sd w/some small gravel (loose)
24	40		Clay caliche w/sand strks	194	200	Yellow ochre
40	60		Clay & caliche w/sand strks & Sandstone lenses			
60	64		Caliche & clay w/some sd strks			
64	86		Fine sand sandstone strks w/ Clay strks			
86	110		Fine to med sd w/clay lenses			
110	123		Fine to med sd w/clay strks & Caliche lenses			
123	151		Fine to med sd w/clay lenses			
151	160		Fine to some med sd w/clay strk			

7 CONTRACTOR'S OR LANDOWNER'S CERTIFICATION: This water well was (1) constructed, (2) reconstructed, or (3) plugged under my jurisdiction and was

completed on (mo/day/yr) **10 30 07** and this record is true to the best of my knowledge and belief. KansasWater Well Contractor's License No. **554** This Water Well Record was completed on (mo/day/yr) **11-05-07**under the business name of **Woofter Pump & Well Inc.**by (signature) *Dee C. Woofter*

INSTRUCTIONS: Please fill in blanks and circle the correct answers. Send three copies to Kansas Department of Health and Environment, Bureau of Water, 1000 S.W. Jackson St., Ste. 420, Topeka, Kansas 66612-1367. Telephone: 913-296-5545. Send one to WATER WELL OWNER and retain one for your records.