

CORRECTION(S) TO WATER WELL RECORD (WWC-5)
(to rectify lacking or incorrect information)

County: Wichita

Location listed as:

Location changed to:

Section-Township-Range: None Given

13-18 S-37 W

Fraction ($\frac{1}{4}$ $\frac{1}{4}$ $\frac{1}{4}$): _____

NW NE SW SW

Other changes: Initial statements: _____

Changed to: _____

Comments: _____

verification method: Written description, city street map,
and mapping tool on KGS website.

initials: DR date: 11/30/2007

submitted by: Kansas Geological Survey, Data Resources Library, 1930 Constant Ave., Lawrence, KS 66047-3726
to: Kansas Dept of Health & Environment, Bureau of Water, 1000 SW Jackson, Suite 420, Topeka, KS 66612-1367.

well 11

WATER WELL PLUGGING RECORD Form WWC-5P KSA 82a-1212 ID NO.

1 LOCATION OF WATER WELL: County: WICHITA Fraction 1/4 1/4 1/4 Section Number Township Number Range Number E/W

Distance and direction from nearest town or city street address of well if located within city?


W. H. ST and W. DESSSE ST

2 WATER WELL OWNER: CITY OF LEOTI Global Positioning Systems (decimal degrees, min. of 4 digits Latitude: Longitude: Elevation: Datum: Data Collection Method:

RR#, St. Address, Box #:

City, State ZIP Code: LEOTI KS 67861

3 MARK WELL'S LOCATION WITH AN "X" IN SECTION BOX:

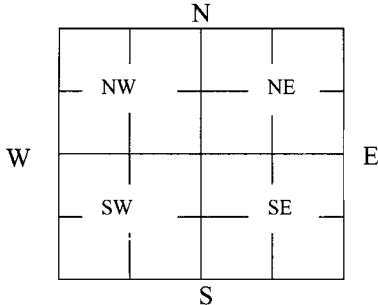

4 DEPTH OF WELL 166 ft. WELL'S STATIC WATER LEVEL 0 ft.

WELL WAS USED AS:

- 1 Domestic 2 Irrigation 3 Feedlot 4 Industrial 5 Public Water Supply 6 Oil Field Water Supply 7 Domestic (Lawn & Garden) 8 Air Conditioning 9 Dewatering 10 Monitoring 11 Injection Well 12 Other Test well

Was a chemical/bacteriological sample submitted to Department? Yes No X

5 TYPE OF BLANK CASING USED: 1 Steel 2 PVC 3 RMP (SR) 4 ABS 5 Wrought 6 Asbestos-Cement 7 Fiberglass 8 Concrete Tile 9 Other (Specify below)

Blank casing diameter 3 in. Was casing pulled? Yes X No If yes, how much 4 F Casing height above or below land surface 36 in.

6 GROUT PLUG MATERIAL: 1 Neat cement 2 Cement grout 3 Bentonite 4 Other

Grout Plug Intervals: From 166 ft. to 7 ft., From 7 ft. to 3 ft., From 3 to 0 ft.

What is the nearest source of possible contamination:

- 1 Septic tank 2 Sewer lines 3 Watertight sewer lines 4 Lateral lines 5 Cess pool 6 Seepage pit 7 Pit privy 8 Sewage lagoon 9 Feedyard 10 Livestock pens 11 Fuel Storage 12 Fertilizer storage 13 Insecticide storage 14 Abandoned water well 15 Oil well/Gas well 16 Other (specify below)

Direction from well? W How many feet? 150 F

Table with columns: FROM, TO, PLUGGING MATERIALS. Rows: 166 to 7 (Sand), 7 to 3 (Bentonite), 3 to 0 (Dirt).

7 CONTRACTOR'S OR LANDOWNER'S CERTIFICATION: This water well was plugged under my jurisdiction and was completed on (mo/day/year) 10-26-07 and this record is true to the best of my knowledge and belief. Kansas Water Well Contractor's License No. Jones Construction by (signature) [Signature]

INSTRUCTIONS: Use typewriter or ballpoint pen. Please press firmly and print clearly. Please fill in blanks, underline or circle the correct answers. Send top three copies to Kansas Department of Health and Environment, Bureau of Water, Geology Section, 1000 SW Jackson St., Ste. 420, Topeka, Kansas 66612-1367. Telephone: 785/296-5522. Send one to Water Well Owner and retain one for your records. Visit us at http://www.kdheks.gov/geo/waterwells.