

CORRECTION(S) TO WATER WELL RECORD (WWC-5)  
(to rectify lacking or incorrect information)

County: Wichita

Location listed as:

Location changed to:

Section-Township-Range: 8-18-37 W

8-18 S-37 W

Fraction ( 1/4 1/4 1/4): None Given

SE NE SE

Other changes: Initial statements: \_\_\_\_\_

Changed to: \_\_\_\_\_

Comments: \_\_\_\_\_


verification method: Legal description, position on plat map,  
and mapping tool on KGS website.

initials: DRJ date: 11/30/2007

submitted by: Kansas Geological Survey, Data Resources Library, 1930 Constant Ave., Lawrence, KS 66047-3726  
to: Kansas Dept of Health & Environment, Bureau of Water, 1000 SW Jackson, Suite 420, Topeka, KS 66612-1367.

**1 LOCATION OF WATER WELL:** County: WICHITA Fraction  $\frac{1}{4}$   $\frac{1}{4}$   $\frac{1}{4}$  Section Number 8 Township Number R12 Range Number 37 W  
 Distance and direction from nearest town or city street address of well if located within city?

**2 WATER WELL OWNER:** JO ZELLNER **Global Positioning Systems** (decimal degrees, min. of 4 digits)  
 RR#, St. Address, Box #: RR#2 Box 189 Latitude: \_\_\_\_\_  
 City, State ZIP Code: LEOTI KS 67261 Longitude: \_\_\_\_\_  
 Elevation: \_\_\_\_\_  
 Datum: \_\_\_\_\_  
 Data Collection Method: \_\_\_\_\_

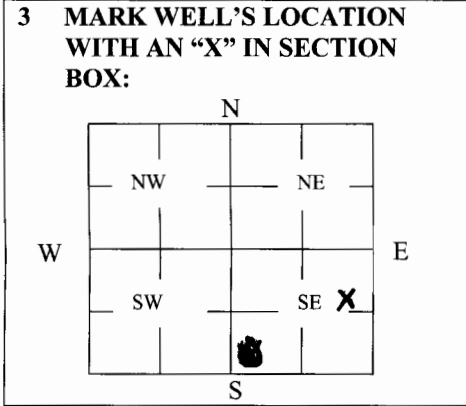

**4 DEPTH OF WELL** 194 ft.  
 WELL'S STATIC WATER LEVEL 0 F ft.  
 WELL WAS USED AS:  
 1 Domestic  5 Public Water Supply  9 Dewatering   
 2 Irrigation  6 Oil Field Water Supply  10 Monitoring   
 3 Feedlot  7 Domestic (Lawn & Garden)  11 Injection Well   
 4 Industrial  8 Air Conditioning  12 Other \_\_\_\_\_  
 Was a chemical/bacteriological sample submitted to Department? Yes \_\_\_\_\_ No

**5 TYPE OF BLANK CASING USED:**  
 Steel  3 RMP (SR)  5 Wrought  7 Fiberglass  9 Other (Specify below) \_\_\_\_\_  
 2 PVC  4 ABS  6 Asbestos-Cement  8 Concrete Tile \_\_\_\_\_  
 Blank casing diameter 16 in. Was casing pulled? Yes  No \_\_\_\_\_ If yes, how much 4 F  
 Casing height above or below land surface 3 F in.

**6 GROUT PLUG MATERIAL:** 1 Neat cement 2 Cement grout 3 Bentonite 4 Other \_\_\_\_\_  
 Grout Plug Intervals: From 194 ft. to 120 ft., From 120 ft. to 7 ft., From 7 to 4 ft.  
 What is the nearest source of possible contamination:  
 1 Septic tank  6 Seepage pit  11 Fuel Storage  16 Other (specify below) IRRIGATION WELL  
 2 Sewer lines  7 Pit privy  12 Fertilizer storage   
 3 Watertight sewer lines  8 Sewage lagoon  13 Insecticide storage   
 4 Lateral lines  9 Feedyard  14 Abandoned water well  Direction from well? N  
 5 Cess pool  10 Livestock pens  15 Oil well/Gas well  How many feet? 1/4 mile

FROM	TO	PLUGGING MATERIALS	FROM	TO	PLUGGING MATERIALS
194	120	Sand			
120	7	Dirt			
7	4	BENTONITE			
4	0	Dirt			

**7 CONTRACTOR'S OR LANDOWNER'S CERTIFICATION:** This water well was plugged under my jurisdiction and was completed on (mo/day/year) 10-24-07 and this record is true to the best of my knowledge and belief. Kansas Water Well Contractor's License No. \_\_\_\_\_. This Water Well Record was completed on (mo/day/year) 10/25-07 under the business name of Jones Construction by (signature) [Signature]

**INSTRUCTIONS:** Use typewriter or ballpoint pen. Please press firmly and print clearly. Please fill in blanks, underline or circle the correct answers. Send top three copies to Kansas Department of Health and Environment, Bureau of Water, Geology Section, 1000 SW Jackson St., Ste. 420, Topeka, Kansas 66612-1367. Telephone: 785/296-5522. Send one to Water Well Owner and retain one for your records. Visit us at <http://www.kdheks.gov/geo/waterwells>.