

CORRECTION(S) TO WATER WELL RECORD (WWC-5)
(to rectify lacking or incorrect information)

County: Wichita

Location listed as:

Section-Township-Range: 34-18 S-37 W

Fraction ($\frac{1}{4}$ $\frac{1}{4}$ $\frac{1}{4}$): NW

Location changed to:

34-18 S-37 W

NW NE NW

Other changes: Initial statements: _____

Changed to: _____

Comments: _____

verification method: County ownership directory, KGS' "WIMAS" & "WIZARD" database records for this well, and mapping tool & aerial photos on KGS website. initials: DRJ date: 9/25/2008

WATER WELL PLUGGING RECORD Form WWC-5P

KSA 82a-1212


ID NO.

1 LOCATION OF WATER WELL:	Fraction	Section Number	Township Number	Range Number
County: <u>WICHITA</u>	<u>NW</u> $\frac{1}{4}$ $\frac{1}{4}$ $\frac{1}{4}$	<u>34</u>	<u>18S</u>	<u>37</u> <u>NW</u>

Distance and direction from nearest town or city street address of well if located within city?

2 WATER WELL OWNER: <u>Joe Beermann</u> <u>Macarice Wikoff</u> RR#, St. Address, Box #: <u>2501 Nevada St</u> <u>Hutchinson, KS 67502</u> City, State ZIP Code: <u>67501-1456</u>	Global Positioning Systems (decimal degrees, min. of 4 digits) Latitude: _____ Longitude: _____ Elevation: _____ Datum: _____ Data Collection Method: _____
---	--

3 MARK WELL'S LOCATION WITH AN "X" IN SECTION BOX:

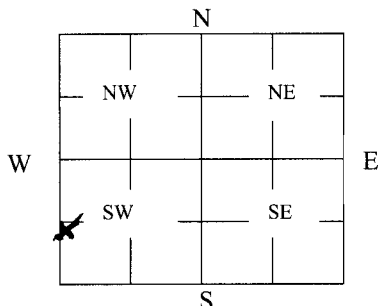

4 DEPTH OF WELL 136 ft.

WELL'S STATIC WATER LEVEL 0 ft

WELL WAS USED AS:

- | | | |
|--|----------------------------|-------------------|
| 1 Domestic | 5 Public Water Supply | 9 Dewatering |
| ☒ 2 Irrigation | 6 Oil Field Water Supply | 10 Monitoring |
| 3 Feedlot | 7 Domestic (Lawn & Garden) | 11 Injection Well |
| 4 Industrial | 8 Air Conditioning | 12 Other _____ |

Was a chemical/bacteriological sample submitted to Department? Yes _____ No ☒

5 TYPE OF BLANK CASING USED:

- | | | | | |
|---|------------|-------------------|-----------------|-------------------------------|
| ☒ 1 Steel | 3 RMP (SR) | 5 Wrought | 7 Fiberglass | 9 Other (Specify below) _____ |
| 2 PVC | 4 ABS | 6 Asbestos-Cement | 8 Concrete Tile | |

Blank casing diameter 16 in. Was casing pulled? Yes ☒ No _____ If yes, how much 4 Feet

Casing height above or below land surface 4F in.

6 GROUT PLUG MATERIAL: 1 Neat cement 2 Cement grout 3 Bentonite 4 Other _____

Grout Plug Intervals: From 136 ft. to 40 ft., From 40 ft. to 7 ft., From 7 to 4 ft.

What is the nearest source of possible contamination:

- | | | | |
|---|-------------------|-------------------------|--------------------------------|
| ☒ 1 Septic tank | 6 Seepage pit | 11 Fuel Storage | 16 Other (specify below) _____ |
| 2 Sewer lines | 7 Pit privy | 12 Fertilizer storage | |
| 3 Watertight sewer lines | 8 Sewage lagoon | 13 Insecticide storage | |
| 4 Lateral lines | 9 Feedyard | 14 Abandoned water well | Direction from well? <u>SW</u> |
| 5 Cess pool | 10 Livestock pens | 15 Oil well/Gas well | How many feet? <u>2600F</u> |

FROM	TO	PLUGGING MATERIALS	FROM	TO	PLUGGING MATERIALS
136	40	Sand			
40	7	Grout			
7	4	Bentonite			
4	0	Grout			

7 CONTRACTOR'S OR LANDOWNER'S CERTIFICATION: This water well was plugged under my jurisdiction and was completed on (mo/day/year) 8-11-08 and this record is true to the best of my knowledge and belief. Kansas Water Well Contractor's License No. _____. This Water Well Record was completed on (mo/day/year) 8-11-08 under the business name of Jones Construction by (signature) Jeff Thompson

INSTRUCTIONS: Use typewriter or ballpoint pen. Please press firmly and print clearly. Please fill in blanks, underline or circle the correct answers. Send top three copies to Kansas Department of Health and Environment, Bureau of Water, Geology Section, 1000 SW Jackson St., Ste. 420, Topeka, Kansas 66612-1367. Telephone: 785/296-5522. Send one to Water Well Owner and retain one for your records. Visit us at <http://www.kdheks.gov/geo/waterwells>.