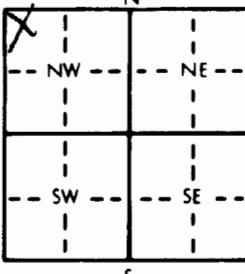
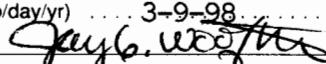


WATER WELL RECORD

Form WWC-5

KSA 82a-1212

1 LOCATION OF WATER WELL:		Fraction County: Wichita	NW 1/4	NW 1/4	NW 1/4	Section Number 26	Township Number T 18 S	Range Number R 37 EW	
Distance and direction from nearest town or city street address of well if located within city?	
2 WATER WELL OWNER: L & R Inc., ATTN: Ralph K. Reitz RR#, St. Address, Box # : P. O. Box 86 City, State, ZIP Code : Lawrence, KS 66044	
3 LOCATE WELL'S LOCATION WITH AN "X" IN SECTION BOX: N  1 Mile	
4 DEPTH OF COMPLETED WELL 180 ft. ELEVATION: Depth(s) Groundwater Encountered 1. ft. 2. ft. 3. ft. WELL'S STATIC WATER LEVEL 128 ft. below land surface measured on mo/day/yr Pump test data: Well water was ft. after hours pumping gpm Est. Yield 28 gpm: Well water was ft. after hours pumping gpm Bore Hole Diameter 180 in. to ft. and in. to ft. WELL WATER TO BE USED AS: 5 Public water supply 8 Air conditioning 11 Injection well 1 Domestic 3 Feedlot 6 Oil field water supply 9 Dewatering 12 Other (Specify below) 2 Irrigation 4 Industrial 7 Lawn and garden only 10 Monitoring well Was a chemical/bacteriological sample submitted to Department? Yes.....No.....X..... If yes, mo/day/yr sample was submitted Water Well Disinfected? Yes No X	
5 TYPE OF BLANK CASING USED: 1 Steel 3 RMP (SR) 5 Wrought iron 8 Concrete tile CASING JOINTS: Glued X Clamped 2 PVC 4 ABS 6 Asbestos-Cement 9 Other (specify below) Welded Blank casing diameter 16 in. to 120 ft. Dia in. to ft. Dia in. to ft. Casing height above land surface 24 in., weight 16.15 lbs./ft. Wall thickness or gauge No. 500	
TYPE OF SCREEN OR PERFORATION MATERIAL: 1 Steel 3 Stainless steel 5 Fiberglass 7 PVC 10 Asbestos-cement 2 Brass 4 Galvanized steel 6 Concrete tile 8 RMP (SR) 11 Other (specify) 12 None used (open hole)	
SCREEN OR PERFORATION OPENINGS ARE: 1 Continuous slot 3 Mill slot 5 Gauzed wrapped 8 Saw cut 11 None (open hole) 2 Louvered shutter 4 Key punched 6 Wire wrapped 9 Drilled holes 7 Torch cut 10 Other (specify)	
SCREEN-PERFORATED INTERVALS: From 120 ft. to 180 ft., From ft. to ft. From ft. to ft., From ft. to ft. GRAVEL PACK INTERVALS: From 20 ft. to 180 ft., From ft. to ft. From ft. to ft., From ft. to ft.	
6 GROUT MATERIAL: 1 Neat cement 2 Cement grout 3 Bentonite 4 Other Grout Intervals: From 0 ft. to 20 ft., From ft. to ft., From ft. to ft. What is the nearest source of possible contamination: NONE 10 Livestock pens 14 Abandoned water well 1 Septic tank 4 Lateral lines 7 Pit privy 11 Fuel storage 15 Oil well/Gas well 2 Sewer lines 5 Cess pool 8 Sewage lagoon 12 Fertilizer storage 16 Other (specify below) 3 Watertight sewer lines 6 Seepage pit 9 Feedyard Direction from well? How many feet?	
<table border="1"> <thead> <tr> <th>FROM</th> <th>TO</th> <th>LITHOLOGIC LOG</th> <th>FROM</th> <th>TO</th> <th>PLUGGING INTERVALS</th> </tr> </thead> <tbody> <tr><td>0</td><td>2</td><td>Surface</td><td>105</td><td>109</td><td>Fine Sand w/Clay</td></tr> <tr><td>2</td><td>9</td><td>Loess</td><td>109</td><td>114</td><td>Sandy Clay</td></tr> <tr><td>9</td><td>24</td><td>Clay & Caliche</td><td>114</td><td>141</td><td>Sandy Clay w/Med. to Fine Sand</td></tr> <tr><td>24</td><td>33</td><td>Med. Sand & Gravel w/Clay Layers</td><td>141</td><td>160</td><td>Med. Sand & Gravel w/Clay Layers</td></tr> <tr><td>33</td><td>40</td><td>Cemented Sand, Clay & Caliche</td><td>160</td><td>165</td><td>Semi-Tight to Med. Sand w/Clay Lr</td></tr> <tr><td>40</td><td>41</td><td>Caliche</td><td>165</td><td>168</td><td>Med. Sand w/Clay Layers</td></tr> <tr><td>41</td><td>50</td><td>Caliche & Clay w/Some Sand</td><td>168</td><td>172</td><td>Sandy Clay w/Med. Sand Strks.</td></tr> <tr><td>50</td><td>63</td><td>Cemented Sand, Clay & Caliche Mix</td><td>172</td><td>175</td><td>Med. Sand w/Clay</td></tr> <tr><td>63</td><td>69</td><td>Cemented Sand-Hard</td><td>175</td><td>180</td><td>Ochre & Shale</td></tr> <tr><td>69</td><td>71</td><td>Cemented Sand w/Clay Strks.</td><td></td><td></td><td></td></tr> <tr><td>71</td><td>80</td><td>Sandy Clay & Caliche</td><td></td><td></td><td></td></tr> <tr><td>80</td><td>85</td><td>Med. Sand w/Clay</td><td></td><td></td><td></td></tr> <tr><td>85</td><td>86</td><td>Cemented Sand, Hard</td><td></td><td></td><td></td></tr> <tr><td>86</td><td>90</td><td>Med. Sand w/Clay</td><td></td><td></td><td></td></tr> <tr><td>90</td><td>105</td><td>Sandy Clay w/Sand Strks.</td><td></td><td></td><td></td></tr>
7 CONTRACTOR'S OR LANDOWNER'S CERTIFICATION: This water well was (1) constructed, (2) reconstructed, or (3) plugged under my jurisdiction and was completed on (mo/day/year) 12-1-91 and this record is true to the best of my knowledge and belief. Kansas Water Well Contractor's License No. 554 This Water Well Record was completed on (mo/day/yr) 3-9-98 under the business name of Woofter Pump & Well, Inc. by (signature) 	
INSTRUCTIONS: Use typewriter or ball point pen. PLEASE PRESS FIRMLY and PRINT clearly. Please fill in blanks, underline or circle the correct answers. Send top three copies to Kansas Department of Health and Environment, Bureau of Water, Topeka, Kansas 66620-0001. Telephone: 913-296-5545. Send one to WATER WELL OWNER and retain one for your records.	