

## WATER WELL PLUGGING RECORD

Form WWC-5P

KSA 82a-1212 ID NO.

6524

## 1 LOCATION OF WATER WELL:

County: Wichita

Fraction

NW  $\frac{1}{4}$  $\frac{1}{4}$  $\frac{1}{4}$ 

Section Number

16

Township Number

18

Range Number

37

E/W

Distance and direction from nearest town or city street address of well if located within city?

N/A

## 2 WATER WELL OWNER:

Thelma G. Miller Farms LLC

RR#, St. Address, Box #:

PO 617

City, State ZIP Code:

Scott City, KS 67871

Global Positioning Systems (decimal degrees, min. of 4 digits)

Latitude: \_\_\_\_\_

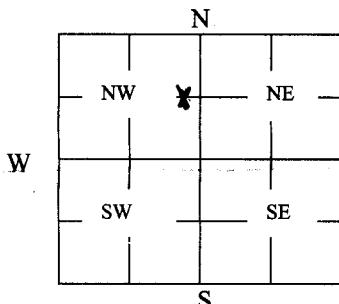
Longitude: \_\_\_\_\_

Elevation: \_\_\_\_\_

Datum: \_\_\_\_\_

Data Collection Method: \_\_\_\_\_

## 3 MARK WELL'S LOCATION WITH AN "X" IN SECTION BOX:

4 DEPTH OF WELL 145 ft.WELL'S STATIC WATER LEVEL None ft

WELL WAS USED AS:

|              |                            |                   |
|--------------|----------------------------|-------------------|
| 1 Domestic   | 5 Public Water Supply      | 9 Dewatering      |
| 2 Irrigation | 6 Oil Field Water Supply   | 10 Monitoring     |
| 3 Feedlot    | 7 Domestic (Lawn & Garden) | 11 Injection Well |
| 4 Industrial | 8 Air Conditioning         | 12 Other _____    |

Was a chemical/bacteriological sample submitted to Department? Yes        No X

## 5 TYPE OF BLANK CASING USED:

|         |            |                   |                 |                         |
|---------|------------|-------------------|-----------------|-------------------------|
| 1 Steel | 3 RMP (SR) | 5 Wrought         | 7 Fiberglass    | 9 Other (Specify below) |
| 2 PVC   | 4 ABS      | 6 Asbestos-Cement | 8 Concrete Tile | _____                   |

Blank casing diameter 16 in. Was casing pulled? Yes X No        If yes, how much 4 ft (48 in)Casing height above or below land surface 48 in.

## 6 GROUT PLUG MATERIAL:

|               |                |             |               |
|---------------|----------------|-------------|---------------|
| 1 Neat cement | 2 Cement grout | 3 Bentonite | 4 Other _____ |
|---------------|----------------|-------------|---------------|

Grout Plug Intervals: From 145 ft. to 7 ft., From 7 ft. to 4 ft., From 4 to 0 ft.

What is the nearest source of possible contamination:

|                          |                   |                         |                                |
|--------------------------|-------------------|-------------------------|--------------------------------|
| 1 Septic tank            | 6 Seepage pit     | 11 Fuel Storage         | 16 Other (specify below)       |
| 2 Sewer lines            | 7 Pit privy       | 12 Fertilizer storage   | _____                          |
| 3 Watertight sewer lines | 8 Sewage lagoon   | 13 Insecticide storage  | _____                          |
| 4 Lateral lines          | 9 Feedyard        | 14 Abandoned water well | Direction from well? <u>SE</u> |
| 5 Cess pool              | 10 Livestock pens | 15 Oil well/Gas well    | How many feet? <u>5000'</u>    |

| FROM | TO | PLUGGING MATERIALS | FROM | TO | PLUGGING MATERIALS |
|------|----|--------------------|------|----|--------------------|
| 145  | 7  | Sand               |      |    |                    |
| 7    | 4  | Bentonite          |      |    |                    |
| 4    | 0  | Dirt               |      |    |                    |
|      |    |                    |      |    |                    |
|      |    |                    |      |    |                    |
7 CONTRACTOR'S OR LANDOWNER'S CERTIFICATION: This water well was plugged under my jurisdiction and was completed on (mo/day/year) 3/30/15 and this record is true to the best of my knowledge and belief. Kansas WaterWell Contractor's License No.       . This Water Well Record was completed on (mo/day/year) 3/30/15 under the business name of Jones Construction Co. by (signature) Mark C. JonesINSTRUCTIONS: Use typewriter or ballpoint pen. Please press firmly and print clearly. Please fill in blanks, underline or circle the correct answers. Send top three copies to Kansas Department of Health and Environment, Bureau of Water, Geology Section, 1000 SW Jackson St., Ste. 420, Topeka, Kansas 66612-1367. Telephone: 785/296-5522. Send one to Water Well Owner and retain one for your records. Visit us at <http://www.kdheks.gov/geo/waterwells>.