USE TYPEWRITER OR BALL POINT PEN-PRESS FIRMLY, PRINT CLEARLY.

WATER WELL RECORD
KSA 82a-1201-1215

Kansas Department of Health and Environment-Division of Environment
(Water well Contractors)
Topeka, Kansas 66620

1. Location of well:	County	Fraction	Section number	Township number	Range number
	Wichita	NE 1/4 NE 1/4 NE 1/4	2	T 18 S	R 37 E (W)

2. Distance and direction from nearest town or city: 3N of Leoti, KS

Street address of well location if in city:

3. Owner of well: Jess Fisher
R.R. or street: RFD #1
City, state, zip code: Leoti, KS 67861

4. Locate with "X" in section below:

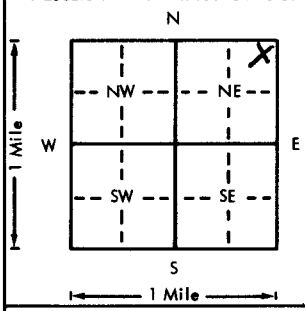

Sketch map:

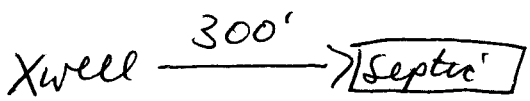

6. Bore hole dia. 9 in. Completion date _____
Well depth 195 ft. 9-14-76

7. __ Cable tool X Rotary __ Driven __ Dug
__ Hollow rod __ Jetted __ Bored __ Reverse rotary

8. Use: X Domestic __ Public supply __ Industry
__ Irrigation __ Air conditioning __ Stock
__ Lawn __ Oil field water __ Other

9. Casing: Material Plas. Height: Above or below
Threaded ___ Welded Glue Surface 12 in.
RMP X PVC ___ Weight 1.8 lbs./ft.
Dia. 5 in. to 175 ft. depth Wall Thickness: inches or
Dia. ___ in. to ___ ft. depth gage No. .250

10. Screen: Manufacturer's name Jess & Lowell
Type RMP Dia. 5 in.
Slot gauze 1/16 Length 20 ft.
Set between 175 ft. and 195 ft.
___ ft. and ___ ft.
Gravel pack? yes Size range of material 1/4-1/8

11. Static water level: mo./day/yr.
141 ft. below land surface Date 9-10-76

12. Pumping level below land surfaces:
151 ft. after 1 hrs. pumping 18 g.p.m.
___ ft. after ___ hrs. pumping ___ g.p.m.
Estimated maximum yield 18 g.p.m.

13. Water sample submitted: mo./day/yr.
__ Yes X No Date ___

14. Well head completion:
X Pitless adapter 12 Inches above grade

15. Well grouted? yes
With: X Neat cement ___ Bentonite ___ Concrete
Depth: From 0 ft. to 15 ft.

16. Nearest source of possible contamination:
ft. 300 Direction E Type Septic
Well disinfected upon completion? X Yes ___ No

17. Pump: ___ Not installed
Manufacturer's name Red Jacket
Model number 150N1 HP 1½ Volts 220
Length of drop pipe 190 ft. capacity 18 g.p.m.
Type:
X Submersible ___ Turbine
___ Jet ___ Reciprocating
___ Centrifugal ___ Other

5. Type and color of material	From	To
Clay	0	32
Gyp	32	60
Clay sdy	60	75
Fine sd clay	75	135
Sd coarse	135	160
Clay	160	164
Fine sd clay	164	180
Sd coarse	180	188
Clay yellow	188	195

(Use a second sheet if needed)

18. Elevation:

Topography:
___ Hill
___ Slope
X Upland
___ Valley

19. Remarks:

20. Water well contractor's certification:
This well was drilled under my jurisdiction and this report is true to the best of my knowledge and belief.
Weishaar Drilling 232
Business name License No.
Address Scott City, KS 67871
Signature [signature] Date
Authorized representative 9-30-76

T 18 R 37 E (W) Sec 2 1/4 NE 1/4 NE 1/4 NE 1/4

Forward the white, blue and pink copies to the Department of Health and Environment

Form WWC-5

M1-1023