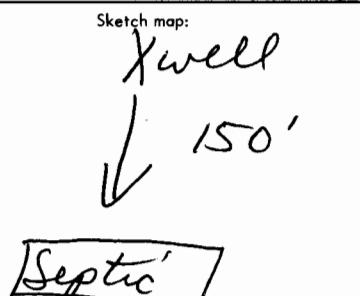


USE TYPEWRITER OR BALL
POINT PEN-PRESS FIRMLY,
PRINT CLEARLY.

WATER WELL RECORD
KSA 82a-1201-1215

Kansas Department of Health and
Environment-Division of Environment
(Water well Contractors)
Topeka, Kansas 66620

1. Location of well:	County	Fraction	Section number	Township number	Range number		
	Wichita	NW 1/4 NW 1/4 NE 1/4	13	T 18 S	R 37 E		
2. Distance and direction from nearest town or city:	In Leoti, Kansas		3. Owner of well:	Ernest Swanson			
Street address of well location if in city:			R.R. or street:				
4. Locate with "X" in section below:	Sketch map:		6. Bore hole dia.	9 in.	Completion date		
			Well depth	180 ft.	3-10-77		
			7. Cable tool	<input checked="" type="checkbox"/> Rotary	Driven <input type="checkbox"/> Dug		
				<input type="checkbox"/> Hollow rod	<input checked="" type="checkbox"/> Jetted	<input type="checkbox"/> Bored	<input type="checkbox"/> Reverse rotary
			8. Use:	<input checked="" type="checkbox"/> Domestic	<input type="checkbox"/> Public supply	<input type="checkbox"/> Industry	
				<input type="checkbox"/> Irrigation	<input type="checkbox"/> Air conditioning	<input type="checkbox"/> Stock	
				<input type="checkbox"/> Lawn	<input type="checkbox"/> Oil field water	<input type="checkbox"/> Other	
5. Type and color of material	From	To	9. Casing: Material	Plas.	Height: above or below		
Clay	0	19	Threaded	Glue	Surface 12 in.		
Gyp	19	24	RMP	X PVC	Weight 1.8 lbs./ft.		
Sd rock	24	38	Dia. 5 in. to 160 ft. depth	Wall Thickness: inches or			
Sdy clay	38	47	Dia. in. to ft. depth	Gage No. 250			
Gyp	47	52	10. Screen: Manufacturer's name	Jess & Lowell			
Clay	52	60	Type	RMP	Dia. 5 in.		
Fine sd clay	60	90	Slot gauze	1/16	Length 20 ft.		
Sd coarse	90	97	Set between	160 ft. and 180 ft.			
Sd rock	97	105	ft. and	ft.			
Fine sd clay	105	115	Gravel pack? <input checked="" type="checkbox"/> yes	Size range of material	1/4-1/8		
Fine sd	115	138	11. Static water level:	mo./day/yr.			
Sd coarse	138	149	129 ft. below land surface	3-7-77			
Clay	149	167	12. Pumping level below land surfaces:				
SD coarse	167	177	139 ft. after 1 hrs. pumping	10 g.p.m.			
Clay yellow	177	182	ft. after hrs. pumping	10 g.p.m.			
Shale	182		Estimated maximum yield	g.p.m.			
18. Elevation:	19. Remarks: Topography: <input type="checkbox"/> Hill <input type="checkbox"/> Slope <input checked="" type="checkbox"/> Upland <input type="checkbox"/> Valley			13. Water sample submitted:	mo./day/yr.		
				Yes <input checked="" type="checkbox"/> No	Date		
				14. Well head completion:			
				<input checked="" type="checkbox"/> Pitless adapter	12 inches above grade		
				15. Well grouted? <input checked="" type="checkbox"/> yes			
				With: <input checked="" type="checkbox"/> Neat cement	Bentonite <input type="checkbox"/> Concrete		
				Depth: From 0 ft. to 15 ft.			
				16. Nearest source of possible contamination:			
				ft. 150	Direction South Type Septic		
				Well disinfected upon completion? <input checked="" type="checkbox"/> Yes	No		
				17. Pump:	Not installed		
				Manufacturer's name	Goulds		
				Model number	EJ 1 HP 1 Volts 220		
				Length of drop pipe	175 ft. capacity 10 g.p.m.		
				Type:			
				<input checked="" type="checkbox"/> Submersible	Turbine <input type="checkbox"/>		
				<input type="checkbox"/> Jet	Reciprocating <input type="checkbox"/>		
				<input type="checkbox"/> Centrifugal	Other <input type="checkbox"/>		
				20. Water well contractor's certification:			
				This well was drilled under my jurisdiction and this report is true to the best of my knowledge and belief.			
				Weishaar Drilling 232			
				Business name	License No.		
				Address	Scott City, KS 67871		
				Signed	Date		
				Authorized representative 3-30-77			