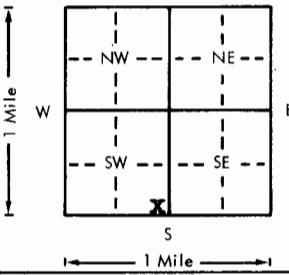
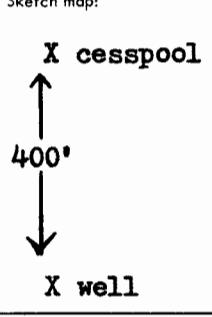


USE TYPEWRITER OR BALL  
POINT PEN-PRESS FIRMLY,  
PRINT CLEARLY.

WATER WELL RECORD  
KSA 82a-1201-1215

Kansas Department of Health and  
Environment-Division of Environment  
(Water well Contractors)  
Topeka, Kansas 66620

1. Location of well:	County <b>Wichita</b>	Fraction <b>S/E 1/4 S/E 1/4 S/W 1/4</b>	Section number <b>14</b>	Township number <b>T 18 S R 37 #W</b>	Range number	
2. Distance and direction from nearest town or city: <b>West edge of city limit, Leoti, Kansas</b>	Street address of well location if in city:	3. Owner of well: <b>Leon Beedy</b>				
4. Locate with "X" in section below:  			Sketch map:  	6. Bore hole dia. <b>9</b> in. Completion date <b>3/15/1978</b> Well depth <b>173</b> ft.		
			7. <input type="checkbox"/> Cable tool <input checked="" type="checkbox"/> Rotary <input type="checkbox"/> Driven <input type="checkbox"/> Dug <input type="checkbox"/> Hollow rod <input type="checkbox"/> Jetted <input type="checkbox"/> Bored <input type="checkbox"/> Reverse rotary			
			8. Use: <input checked="" type="checkbox"/> Domestic <input type="checkbox"/> Public supply <input type="checkbox"/> Industry <input type="checkbox"/> Irrigation <input type="checkbox"/> Air conditioning <input type="checkbox"/> Stock <input type="checkbox"/> Lawn <input type="checkbox"/> Oil field water <input type="checkbox"/> Other			
			9. Casing: Material <input checked="" type="checkbox"/> Plastic <input type="checkbox"/> Wood <input type="checkbox"/> Copper Threaded <input type="checkbox"/> Welded <input checked="" type="checkbox"/> Glued <input type="checkbox"/> Surface <b>12</b> in. RMP <input checked="" type="checkbox"/> PVC <input type="checkbox"/> Weight <b>1.8</b> lbs./ft. Dia. <b>5</b> in. to <b>153</b> ft. depth Wall Thickness: inches or Dia. <b>5</b> in. to <b>153</b> ft. depth Gage No. <b>.250</b>			
5. Type and color of material			From <b>0 9</b>	To <b>15 22</b>	10. Screen: Manufacturer's name <b>Jess &amp; Lowell</b> Type <b>RMP</b> Dia. <b>5"</b> Slot/gauze <b>1/16</b> Length <b>20'</b> Set between <b>153</b> ft. and <b>173</b> ft. ft. and <b>173</b> ft. Gravel pack <b>yes</b> Size range of material <b>1/4X1/8"</b>	
			22 29	11. Static water level: <b>120</b> ft. below land surface Date <b>3/13/1978</b>	mo./day/yr.	
			29 42	12. Pumping level below land surfaces: <b>140</b> ft. after <b>2</b> hrs. pumping <b>25</b> g.p.m. ft. after <b>2</b> hrs. pumping <b>25</b> g.p.m. Estimated maximum yield <b>25</b> g.p.m.		
			42 49	13. Water sample submitted: Yes <input checked="" type="checkbox"/> No <input type="checkbox"/> Date	mo./day/yr.	
			49 52	14. Well head completion: <input checked="" type="checkbox"/> Pitless adapter <b>12</b> Inches above grade		
			52 61	15. Well grouted? <b>yes</b> With: <input checked="" type="checkbox"/> Neat cement <input type="checkbox"/> Bentonite <input type="checkbox"/> Concrete Depth: From <b>0</b> ft. to <b>130</b> ft.		
			61 64	16. Nearest source of possible contamination: ft. <b>400</b> Direction <b>N</b> Type <b>Cesspool</b>		
			64 90	Well disinfected upon completion? <input checked="" type="checkbox"/> Yes <input type="checkbox"/> No		
			90 158	17. Pump: Manufacturer's name <b>Gould</b> Not installed		
			158 168	Model number <b>25EL</b> HP <b>2</b> Volts <b>230</b> Length of drop pipe <b>166</b> ft. capacity <b>25</b> g.p.m.		
			168 173	Type: <input checked="" type="checkbox"/> Submersible <input type="checkbox"/> Turbine <input type="checkbox"/> Jet <input type="checkbox"/> Reciprocating <input type="checkbox"/> Centrifugal <input type="checkbox"/> Other		
(Use a second sheet if needed)						
18. Elevation:	19. Remarks:					20. Water well contractor's certification: This well was drilled under my jurisdiction and this report is true to the best of my knowledge and belief. <b>Weishaar Drilling &amp; Sup. 232</b> Business name <b>Scott City, KS 67871</b> License No. Address <b>411 S. Main</b> Date <b>4/18/78</b> Signature <b>John Weishaar</b> Authorized Representative
Topography: <input type="checkbox"/> Hill <input type="checkbox"/> Slope <input checked="" type="checkbox"/> Upland <input type="checkbox"/> Valley						

Forward the white, blue and pink copies to the Department of Health and Environment

Form WWC-5