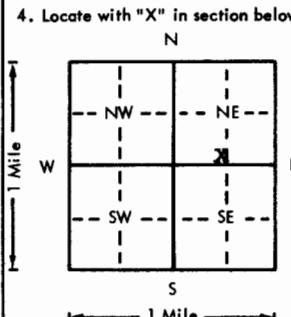


USE TYPEWRITER OR BALL
POINT PEN-PRESS FIRMLY,
PRINT CLEARLY.

WATER WELL RECORD
KSA 82a-1201-1215

Kansas Department of Health and
Environment-Division of Environment
(Water well Contractors)
Topeka, Kansas 66620

1. Location of well:	County	Fraction	Section number	Township number	Range number	
Wichita		SE 1/4 SW 1/4 NE 1/4	17	T 18	S R 37 E <i>W</i>	
2. Distance and direction from nearest town or city: 4W, $\frac{1}{2}$ N, $\frac{3}{4}$ E	Street address of well location if in city: Of Lecti, KS	3. Owner of well: R.R. or street: City, state, zip code:	Stanford D. Splitter 3031 Telegraph Ave. Berkeley, California 94705			
4. Locate with "X" in section below: 	Sketch map:	6. Bore hole dia. 26 in. Completion date 1-18-75 Well depth 196 ft.				
5. Type and color of material	From	To	7. <input type="checkbox"/> Cable tool <input type="checkbox"/> Rotary <input type="checkbox"/> Driven <input type="checkbox"/> Dug <input type="checkbox"/> Hollow rod <input type="checkbox"/> Jetted <input type="checkbox"/> Bored <input checked="" type="checkbox"/> Reverse rotary			
Clay	0	34	8. Use: <input type="checkbox"/> Domestic <input type="checkbox"/> Public supply <input type="checkbox"/> Industry <input checked="" type="checkbox"/> Irrigation <input type="checkbox"/> Air conditioning <input type="checkbox"/> Stock <input type="checkbox"/> Lawn <input type="checkbox"/> Oil field water <input type="checkbox"/> Other			
Gyp	34	65	9. Casing: Material <input checked="" type="checkbox"/> steel Height: Above or below Threaded <input type="checkbox"/> Welded <input checked="" type="checkbox"/> Surface 10 in. RMP <input type="checkbox"/> PVC <input type="checkbox"/> Weight 31.67 lbs./ft. Dia. 16 in. to 196 ft. depth Wall thickness: inches or Dia. <input type="checkbox"/> in. to <input type="checkbox"/> ft. depth gage No. 188			
Clay	65	115	10. Screen: Manufacturer's name <input type="checkbox"/> Free Flow Type <input checked="" type="checkbox"/> Prime Steel Dia. 16 in. Slot gauze .125 Length 40 ft. Set between 156 ft. and 196 ft. ft. and <input type="checkbox"/> ft. Gravel pack? <input checked="" type="checkbox"/> Yes Size range of material 3/4-1			
Fine sd clay	115	121	11. Static water level: mo./day/yr. 136 ft. below land surface Date 10-25-74			
Clay	121	130	12. Pumping level below land surfaces: 164 ft. after 4 hrs. pumping 640 g.p.m. 170 ft. after 4 hrs. pumping 700 g.p.m. Estimated maximum yield 700 g.p.m.			
Fine sd clay	130	138	13. Water sample submitted: mo./day/yr. Yes <input checked="" type="checkbox"/> No <input type="checkbox"/> Date			
Sd coarse	138	150	14. Well head completion: Pitless adapter 12 inches above grade			
Med sd good	150	163	15. Well grouted? <input checked="" type="checkbox"/> With: <input type="checkbox"/> Neat cement <input type="checkbox"/> Bentonite <input checked="" type="checkbox"/> Concrete Depth: From 0 ft. to 10 ft.			
Sd coarse	163	171	16. Nearest source of possible contamination: ft. 2640 Direction S Type lot Well disinfected upon completion? <input checked="" type="checkbox"/> Yes <input type="checkbox"/> No			
Clay	171	174	17. Pump: Not installed Manufacturer's name <input checked="" type="checkbox"/> Western Land Roller Model number GS HP 60 Volts 460 Length of drop pipe 185 ft. capacity 200 g.p.m. Type: <input type="checkbox"/> Submersible <input checked="" type="checkbox"/> Turbine <input type="checkbox"/> Jet <input type="checkbox"/> Reciprocating <input type="checkbox"/> Centrifugal <input type="checkbox"/> Other			
Sd coarse	174	192	18. Elevation:	19. Remarks: (Use a second sheet if needed)	20. Water well contractor's certification: This well was drilled under my jurisdiction and this report is true to the best of my knowledge and belief. Weishaar Drilling 232 Business name <input checked="" type="checkbox"/> Scott City, KS 67871 License No. Address <input checked="" type="checkbox"/> Signed <input type="checkbox"/> Date Signature <input type="checkbox"/> Authorized representative 7-19-76	
Topography: <input type="checkbox"/> Hill <input type="checkbox"/> Slope <input checked="" type="checkbox"/> Upland <input type="checkbox"/> Valley						