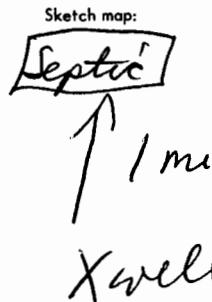


USE TYPEWRITER OR BALL
POINT PEN-PRESS FIRMLY,
PRINT CLEARLY.

WATER WELL RECORD
KSA 82a-1201-1215

Kansas Department of Health and
Environment-Division of Environment
(Water well Contractors)
Topeka, Kansas 66620

1. Location of well:	County Wichita	Fraction SE 1/4 SW 1/4 SW 1/4	Section number 24	T 18 S R	Range number 37 EW	
2. Distance and direction from nearest town or city:	1S, $\frac{1}{4}$ W of Leoti, KS	3. Owner of well: R.R. or street: City, state, zip code:	Parish Land Co. % Wm. Barnum Leoti, KS 67861			
4. Locate with "X" in section below:	Sketch map: 			6. Bore hole dia. 26 in. Completion date 12-20-75 Well depth 155 ft.		
			7. <input type="checkbox"/> Cable tool <input type="checkbox"/> Rotary <input type="checkbox"/> Driven <input type="checkbox"/> Dug <input type="checkbox"/> Hollow rod <input type="checkbox"/> Jetted <input type="checkbox"/> Bored <input checked="" type="checkbox"/> Reverse rotary			
			8. Use: <input type="checkbox"/> Domestic <input type="checkbox"/> Public supply <input type="checkbox"/> Industry <input checked="" type="checkbox"/> Irrigation <input type="checkbox"/> Air conditioning <input type="checkbox"/> Stock <input type="checkbox"/> Lawn <input type="checkbox"/> Oil field water <input type="checkbox"/> Other			
			9. Casing: Material Steel Height: <input type="checkbox"/> Above or below Threaded <input type="checkbox"/> Welded <input checked="" type="checkbox"/> Surface 10 in. RMP <input type="checkbox"/> PVC <input type="checkbox"/> Weight 31.67 lbs./ft. Dia 16 in. to 155 ft. depth Wall Thickness: inches or Dia. in. to ft. depth gage No. 188			
5. Type and color of material			From	To	10. Screen: Manufacturer's name Free Flow	
Clay			0	19	Type Prime Steel Dia. 16 in.	
Sd coarse			19	26	<input type="checkbox"/> Mesh gauze 125 Length 30 ft.	
Sd T			26	35	Set between 125 ft. and 155 ft.	
Rock H			35	41	ft. and ft.	
Gyp			41	55	Gravel pack? yes Size range of material 3/4 -	
Fine sd clay			55	67		
Sdy clay			67	71		
Sd coarse			71	77		
Fine sd clay			77	121		
Sd coarse			121	148		
Yellow			148	153		
Shale			153	155		
(Use a second sheet if needed)						
18. Elevation:	19. Remarks:					20. Water well contractor's certification: This well was drilled under my jurisdiction and this report is true to the best of my knowledge and belief.
Topography:						<u>Waishaar Drilling</u> 232
<input type="checkbox"/> Hill						Business name <u>Septic City, KS 67861</u> License No.
<input type="checkbox"/> Slope						Address <u>Septic City, KS 67861</u>
<input checked="" type="checkbox"/> Upland						Signature <u>John Waishaar</u> Date <u>7-20-76</u>
<input type="checkbox"/> Valley						Authorized representative <u>John Waishaar</u> Date <u>7-20-76</u>

Forward the white, blue and pink copies to the Department of Health and Environment

~~Form WWC-5~~