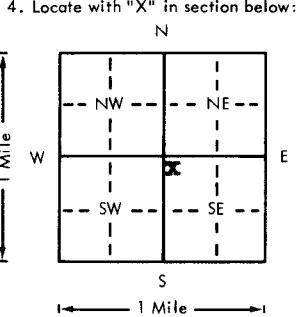


USE TYPEWRITER OR BALL  
POINT PEN-PRESS FIRMLY,  
PRINT CLEARLY.

**WATER WELL RECORD**  
**KSA 82g-1201-1215**

Kansas Department of Health and  
Environment-Division of Environment  
(Water well Contractors)  
Topeka, Kansas 66620

1. Location of well:	County <b>Wichita</b>	Fraction <b>N/4 N/4 S/4</b>	Section number <b>25</b>	Township number <b>T 18 S</b>	Range number <b>R 37 #W</b>		
2. Distance and direction from nearest town or city: <b>1 1/2 S of Leoti, Kansas</b>	Street address of well location if in city:		3. Owner of well: R.R. or street: City, state, zip code: <b>Leoti Spraying Service Leoti, Kansas 67861</b>				
4. Locate with "X" in section below:	Sketch map: 		Sketch map: <b>X Farmstead</b> 300' <b>X well</b>				
5. Type and color of material	From	To	6. Bore hole dia. <b>9</b> in. Completion date <b>8/14/1978</b> Well depth <b>144</b> ft.				
clay	0	25	7. Use: <input checked="" type="checkbox"/> Domestic <input type="checkbox"/> Public supply <input type="checkbox"/> Industry <input type="checkbox"/> Irrigation <input type="checkbox"/> Air conditioning <input type="checkbox"/> Stock <input type="checkbox"/> Lawn <input type="checkbox"/> Oil field water <input type="checkbox"/> Other				
sand coarse	25	28	8. Use: <input checked="" type="checkbox"/> Domestic <input type="checkbox"/> Public supply <input type="checkbox"/> Industry <input type="checkbox"/> Irrigation <input type="checkbox"/> Air conditioning <input type="checkbox"/> Stock <input type="checkbox"/> Lawn <input type="checkbox"/> Oil field water <input type="checkbox"/> Other				
clay	28	30	9. Casing: Material <b>Plastic</b> Height: Above or below Threaded <input type="checkbox"/> Welded <b>glue</b> Surface <b>12</b> in. RMP <b>X</b> PVC Weight <b>1.8</b> lbs./ft. Dia. <b>5</b> in. to <b>124</b> ft. depth Wall Thickness: inches or Dia. <b>5</b> in. to <b>124</b> ft. depth Gauge No. <b>.250</b>				
sand coarse	30	46	10. Screen: Manufacturer's name <b>Jess &amp; Lowell</b>				
sand rock H	46	55	Type <b>RMP</b> Dia. <b>5"</b> Slot/gauze <b>1/16"</b> Length <b>20'</b> Set between <b>124</b> ft. and <b>144</b> ft. ft. and <b>144</b> ft. Gravel pack? <b>yes</b> Size range of material <b>1/8" X 1/8"</b>				
clay	55	65	11. Static water level: <b>112</b> ft. below land surface Date <b>8/10/1978</b>				
sand coarse	65	81	12. Pumping level below land surfaces: <b>125</b> ft. after <b>2</b> hrs. pumping <b>10</b> g.p.m. ft. after <b>hrs.</b> pumping <b>g.p.m.</b> Estimated maximum yield <b>10</b> g.p.m.				
clay	81	86	13. Water sample submitted: <b>Yes</b> <input checked="" type="checkbox"/> <b>No</b> Date <b>mo./day/yr.</b>				
sand coarse	86	89	14. Well head completion: <b>X</b> Pitless adapter <b>12</b> inches above grade				
clay	89	93	15. Well grouted? <b>yes</b> With: <input checked="" type="checkbox"/> Neat cement <input type="checkbox"/> Bentonite <input type="checkbox"/> Concrete Depth: From <b>0</b> ft. to <b>15</b> ft.				
fine sand clay	93	125	16. Nearest source of possible contamination: ft. <b>300</b> Direction <b>North</b> Type <b>Farmstead</b> Well disinfected upon completion? <b>yes</b> Yes <b>No</b>				
sand coarse	125	130	17. Pump: Manufacturer's name <b>Red Jacket</b> Model number <b>N14BC</b> HP <b>1</b> Volts <b>230</b> Length of drop pipe <b>140</b> ft. capacity <b>10</b> g.p.m.				
clay	130	133	Type: <input checked="" type="checkbox"/> Submersible <input type="checkbox"/> Turbine <input type="checkbox"/> Jet <input type="checkbox"/> Reciprocating <input type="checkbox"/> Centrifugal <input type="checkbox"/> Other				
sand coarse	133	140	18. Elevation:				
clay yellow	140	144	19. Remarks:  <b>(Use a second sheet if needed)</b>				
				20. Water well contractor's certification: This well was drilled under my jurisdiction and this report is true to the best of my knowledge and belief. <b>Weishaar Drilling Supply 232</b> Business name <b>Weishaar Drilling Supply 232</b> License No. <b>67871</b> Address <b>Scott City, Kansas 67871</b> Signed <b>Weishaar Drilling Supply 232</b> Date <b>8/19/1978</b> Authorized Representative <b>Weishaar Drilling Supply 232</b>			
Topography: <input type="checkbox"/> Hill <input type="checkbox"/> Slope <input checked="" type="checkbox"/> Upland <input type="checkbox"/> Valley							

Forward the white, blue and pink copies to the Department of Health and Environment

Form WW2-5