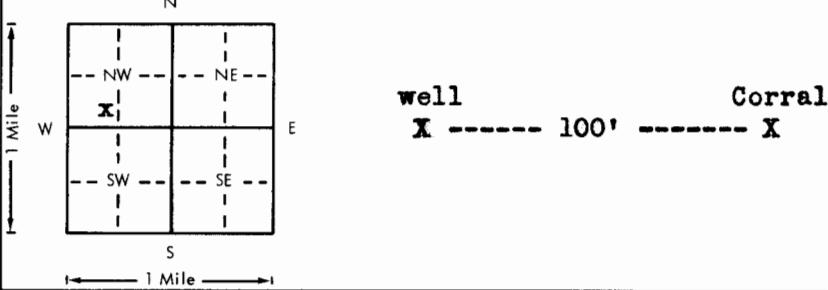


USE TYPEWRITER OR BALL
POINT PEN-PRESS FIRMLY,
PRINT CLEARLY.

WATER WELL RECORD
KSA 82a-1201-1215

Kansas Department of Health and
Environment-Division of Environment
(Water well Contractors)
Topeka, Kansas 66620

1. Location of well:	County Wichita	Fraction S/8¹/₄ S/W¹/₄ N/W¹/₄	Section number 34	Township number T 18 S 37 #W	Range number		
2. Distance and direction from nearest town or city: 2 1/2 W., 2 1/2 S. of Leoti, Kansas Street address of well location if in city:	3. Owner of well: Maurice Wikoff R.R. or street: Leoti, Kansas 67861 City, state, zip code:						
4. Locate with "X" in section below: 	Sketch map:						
5. Type and color of material	From	To	6. Bore hole dia. <u>9</u> in. Completion date <u>9-6-1978</u> Well depth <u>100</u> ft.				
clay	0	23	7. <input checked="" type="checkbox"/> Cable tool <input checked="" type="checkbox"/> Rotary <input type="checkbox"/> Driven <input type="checkbox"/> Dug <input type="checkbox"/> Hollow rod <input type="checkbox"/> Jetted <input type="checkbox"/> Bored <input type="checkbox"/> Reverse rotary				
fine sand	23	28	8. Use: <input checked="" type="checkbox"/> Domestic <input type="checkbox"/> Public supply <input type="checkbox"/> Industry <input type="checkbox"/> Irrigation <input type="checkbox"/> Air conditioning <input type="checkbox"/> Stock <input type="checkbox"/> Lawn <input type="checkbox"/> Oil field water <input type="checkbox"/> Other				
sand coarse	28	38	9. Casing: Material Plastic Height: Above or below Threaded <input type="checkbox"/> Welded glue Surface <u>12</u> in. RMP <input checked="" type="checkbox"/> PVC <input type="checkbox"/> Weight <u>1.8</u> lbs./ft. Dia. <u>5</u> in. to <u>80</u> ft. depth Wall Thickness: inches or Dia. <u>5</u> in. to <u>ft.</u> depth gage No. <u>250</u>				
clay	38	40	10. Screen: Manufacturer's name Jess & Lowell Type RMP Dia. <u>5"</u> Slot/gauze <u>1/16"</u> Length <u>20'</u> Set between <u>80</u> ft. and <u>100</u> ft. ft. and <u>ft.</u> Gravel pack? yes Size range of material <u>1/8"</u>				
sand rock	40	42	11. Static water level: <u>77</u> ft. below land surface Date <u>9/5/78</u>				
clay	42	51	12. Pumping level below land surfaces: <u>95</u> ft. after <u>1</u> hrs. pumping <u>10</u> g.p.m. <u>ft.</u> after <u>hrs.</u> pumping <u>g.p.m.</u> Estimated maximum yield <u>10</u> g.p.m.				
fine sand clay	51	93	13. Water sample submitted: <u>mo./day/yr.</u> <u>Yes</u> <input checked="" type="checkbox"/> <u>No</u> <u>Date</u>				
sand # ^{1/2} fine to med.	93	97	14. Well head completion: <input checked="" type="checkbox"/> Pitless adapter <u>12</u> Inches above grade				
clay yellow	97	110	15. Well grouted? yes With: <input checked="" type="checkbox"/> Neat cement <input type="checkbox"/> Bentonite <input type="checkbox"/> Concrete Depth: From <u>0</u> ft. to <u>15</u> ft.				
shale	110		16. Nearest source of possible contamination: ft <u>100</u> Direction East Type Corral Well disinfected upon completion? yes <u>Yes</u> <u>No</u>				
(Use a second sheet if needed)			17. Pump: Not installed Manufacturer's name Gould Pump Model number 10EJ HP <u>1</u> Volts <u>230</u> Length of drop pipe <u>90</u> ft. capacity <u>10</u> g.p.m. Type: <input checked="" type="checkbox"/> Submersible <input type="checkbox"/> Turbine <input type="checkbox"/> Jet <input type="checkbox"/> Reciprocating <input type="checkbox"/> Centrifugal <input type="checkbox"/> Other				
18. Elevation:	19. Remarks:					20. Water well contractor's certification: This well was drilled under my jurisdiction and this report is true to the best of my knowledge and belief. Weishaar Drilling & Sup. 232 Business name <u>Sedg City KS 67871</u> License No. Address <u>Sedg City KS 67871</u> Signed <u>John Weihsaer</u> Date <u>9/22/78</u> Authorized representative	

Forward the white, blue and pink copies to the Department of Health and Environment

Form WWC-3