


WATER WELL RECORD Form WWC-5 KSA 82a-1212

1 LOCATION OF WATER WELL: Fraction Section Number Township Number Range Number  
 COUNTY: 102 WICHITA NE 1/4 NW 1/4 NW 1/4 10 T 18 S R 38 W

Distance and direction from nearest town or city street address of well if located within city?  
 FROM SELKIRK; APPZ 2 MILES NORTH & 1 MILE EAST

2 WATER WELL OWNER: ARTHUR LOY OLDHAM TRUST  
 RR#, St. Address, Box #: PO BOX 267 Board of Agriculture, Division of Water Resources  
 City, State, ZIP code: LEOTI, KS 67861-0267 Application Number: 8253 & 6847

3 LOCATE WELL'S LOCATION WITH AN "X" IN SECTION BOX:

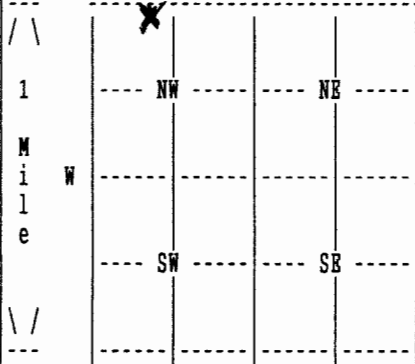

4 DEPTH OF COMPLETED WELL 210 ELEVATION: 0  
 Depth(s) Groundwater Encountered 1. 0 ft. 2. 0 ft. 3. 0 ft.

WELL'S STATIC WATER LEVEL 170 ft. below land surface measured on mo/day/yr 6/29/05  
 Pump test data: Well water was 0 ft. after 0 hours pumping 0 gpm

Estimated Yield 0 gpm: Well water was 0 ft. after 0 hours pumping 0 gpm

Bore Hole Diameter 24 in. to 210 ft., and in. to 0 ft.

WELL WATER TO BE USED AS: 02 IRRIGATION

Was a chemical/bacteriological sample submitted to department? No ;  
 If yes, mo/day/yr sample was submitted Water well disinfected? Yes

5 TYPE OF BLANK CASING USED: 01 STEEL CASING JOINTS: WELDED  
 Blank casing diameter 16 in. to 210 ft., Dia in. to 0 ft., Dia in. to 0 ft.  
 Casing height above land surface 12 in., weight 42 lbs/ft. Wall thickness or gauge No. .250  
 TYPE OF SCREEN OR PERFORATION MATERIAL: 01 STEEL  
 SCREEN OR PERFORATION OPENINGS ARE: 01 CONT. SLOT

SCREEN PERFORATED INTERVALS: From 167 ft. to 197 ft., From 0 ft. to 0 ft.  
 From 0 ft. to 0 ft., From 0 ft. to 0 ft.  
 GRAVEL PACK INTERVALS: From 20 ft. to 210 ft., From 0 ft. to 0 ft.  
 From 0 ft. to 0 ft., From 0 ft. to 0 ft.

6 GROUT MATERIAL 03 BENTONITE  
 Grout Intervals: From 0 ft. to 20 ft., From 0 ft. to 0 ft., From 0 ft. to 0 ft.  
 What is the nearest source of possible contamination: 14 ABAND. WELL  
 Direction from well? SOUTHWEST How many feet? 52

FROM	TO	LITHOLOGIC LOG	FROM	TO	PLUGGING INTERVALS
0	2	02 SILT			
2	65	04 SANDY CLAY 20 LIMESTONE			
65	86	05 SAND 13 FINE GRAVEL 14 MED GRAVEL			
86	103	04 SANDY CLAY 20 LIMESTONE 05 SAND			
103	130	05 SAND			
130	135	04 SANDY CLAY			
135	172	05 SAND 13 FINE GRAVEL 14 MED GRAVEL			
172	175	04 SANDY CLAY			
175	197	04 SANDY CLAY 13 FINE GRAVEL 14 MED GRAVEL			
197	199	31 CALICHE			

7 CONTRACTOR'S OR LANDOWNER'S CERTIFICATION: This water well was Constructed under my jurisdiction and was completed on (mo/day/year) 07/01/05 and this record is true to the best of my knowledge and belief. Kansas Water Well Contractor's License No. 145 This Water Well Record was completed on (mo/day/yr) 07/22/05 under the business name of HENKLE DRILLING & SUPPLY by (signature)

(Continued)

WATER WELL RECORD Form WWC-5 KSA 82a-1212

1 LOCATION OF WATER WELL: COUNTY: 102 WICHITA	Fraction NE 1/4 NW 1/4 NW 1/4	Section Number 10	Township Number T 18 S	Range Number R 38 W
--	----------------------------------	----------------------	---------------------------	------------------------

2 WATER WELL OWNER: ARTHUR LOY OLDEHAM TRUST  
RR#, St. Address, Box # : PO BOX 267  
City, State, ZIP code : LEOTI, KS 67861-0267

Board of Agriculture, Division of Water Resources  
Application Number: 8253 & 6847

FROM	TO	LITHOLOGIC LOG
199	200	19 SHALE

7 CONTRACTOR'S OR LANDOWNER'S CERTIFICATION: This water well was Constructed under my jurisdiction and was completed on (mo/day/year) 07/01/05 and this record is true to the best of my knowledge and belief. Kansas Water Well Contractor's License No. 145 This Water Well Record was completed on (mo/day/yr) 07/22/05 under the business name of HENKLE DRILLING & SUPPLY by (signature)