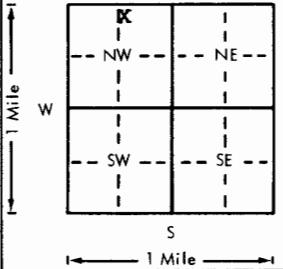
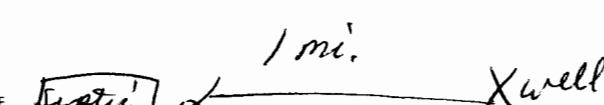
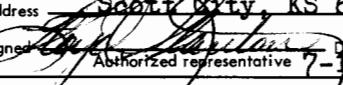


USE TYPEWRITER OR BALL
POINT PEN-PRESS FIRMLY,
PRINT CLEARLY.

WATER WELL RECORD
KSA 82a-1201-1215

Kansas Department of Health and
Environment-Division of Environment
(Water well Contractors)
Topeka, Kansas 66620

1. Location of well:	County	Fraction	Section number	Township number	Range number
	Wichita	NW 1/4 NE 1/4 NW 1/4	3	T 18	S R 38 E 1/2
2. Distance and direction from nearest town or city:	3N, 1 1/2 E of		3. Owner of well:	Frank Whitham	
Street address of well location if in city:	Selkirk, KS		R.R. or street:	Box 9	
4. Locate with "X" in section below:	Sketch map:		6. Bore hole dia.	24 in. Completion date	
				Well depth	200 ft. 2-17-75
5. Type and color of material	From	To	7. Cable tool	Rotary	Driven Dug
Clay	0	23	<input type="checkbox"/>	<input type="checkbox"/>	<input type="checkbox"/>
Gyp	23	39	<input type="checkbox"/>	<input type="checkbox"/>	<input type="checkbox"/>
Clay	39	49	<input type="checkbox"/>	<input type="checkbox"/>	<input type="checkbox"/>
Gyp	49	51	<input type="checkbox"/>	<input type="checkbox"/>	<input type="checkbox"/>
Clay	51	59	<input type="checkbox"/>	<input type="checkbox"/>	<input type="checkbox"/>
Sd coarse	59	62	<input type="checkbox"/>	<input type="checkbox"/>	<input type="checkbox"/>
Clay	62	68	<input type="checkbox"/>	<input type="checkbox"/>	<input type="checkbox"/>
Sd rock	68	69	<input type="checkbox"/>	<input type="checkbox"/>	<input type="checkbox"/>
Fine sd clay	69	74	<input type="checkbox"/>	<input type="checkbox"/>	<input type="checkbox"/>
Sd rock	74	78	<input type="checkbox"/>	<input type="checkbox"/>	<input type="checkbox"/>
Clay	78	90	<input type="checkbox"/>	<input type="checkbox"/>	<input type="checkbox"/>
Fine sd clay	90	105	<input type="checkbox"/>	<input type="checkbox"/>	<input type="checkbox"/>
Clay	105	111	<input type="checkbox"/>	<input type="checkbox"/>	<input type="checkbox"/>
Fine sd clay	111	115	<input type="checkbox"/>	<input type="checkbox"/>	<input type="checkbox"/>
Sd rock	115	117	<input type="checkbox"/>	<input type="checkbox"/>	<input type="checkbox"/>
Clay	117	129	<input type="checkbox"/>	<input type="checkbox"/>	<input type="checkbox"/>
Fine sd clay	129	148	<input type="checkbox"/>	<input type="checkbox"/>	<input type="checkbox"/>
Sd coarse	148	155	<input type="checkbox"/>	<input type="checkbox"/>	<input type="checkbox"/>
Clay	155	158	<input type="checkbox"/>	<input type="checkbox"/>	<input type="checkbox"/>
Sd coarse	158	165	<input type="checkbox"/>	<input type="checkbox"/>	<input type="checkbox"/>
Sd T	165	166	<input type="checkbox"/>	<input type="checkbox"/>	<input type="checkbox"/>
Sd coarse	166	179	<input type="checkbox"/>	<input type="checkbox"/>	<input type="checkbox"/>
Clay	179	183	<input type="checkbox"/>	<input type="checkbox"/>	<input type="checkbox"/>
Sd coarse	183	185	<input type="checkbox"/>	<input type="checkbox"/>	<input type="checkbox"/>
Clay	185	188	<input type="checkbox"/>	<input type="checkbox"/>	<input type="checkbox"/>
Sd coarse	188	192	<input type="checkbox"/>	<input type="checkbox"/>	<input type="checkbox"/>
Clay	192	200	<input type="checkbox"/>	<input type="checkbox"/>	<input type="checkbox"/>
Yellow	200	205	<input type="checkbox"/>	<input type="checkbox"/>	<input type="checkbox"/>
Shale	205		<input type="checkbox"/>	<input type="checkbox"/>	<input type="checkbox"/>
(Use a second sheet if needed)			10. Screen: Manufacturer's name	Free Flow	
18. Elevation:	19. Remarks:		Type	Prime Steel Dia. 16 in.	
Topography:			Slot/gauze	.179 Length 40 ft.	
<input type="checkbox"/> Hill			Set between	160 ft. and 200 ft.	
<input type="checkbox"/> Slope			yes	Size range of material 3/4 -	
<input checked="" type="checkbox"/> Upland			11. Static water level:	mo./day/yr. 136 ft. below land surface Date 11-21-74	
<input type="checkbox"/> Valley			12. Pumping level below land surfaces:	154 ft. after 4 hrs. pumping 360 g.p.m.	
				180 ft. after 4 hrs. pumping 500 g.p.m.	
			Estimated maximum yield	500 g.p.m.	
			13. Water sample submitted:	mo./day/yr. Yes <input checked="" type="checkbox"/> No Date	
			14. Well head completion:	Pitless adapter 12 Inches above grade	
			15. Well grouted?	With: Neat cement Bentonite Concrete Depth: From 10 ft. to 15 ft.	
			16. Nearest source of possible contamination:	ft. 5280 Direction W Type Septic	
			Well disinfected upon completion?	<input checked="" type="checkbox"/> Yes No	
			17. Pump:	Not installed Manufacturer's name Simmons Model number GE HP 40 Volts 460 Length of drop pipe 190 ft. capacity 500 g.p.m. Type:	
				<input type="checkbox"/> Submersible <input checked="" type="checkbox"/> Turbine <input type="checkbox"/> Jet <input type="checkbox"/> Reciprocating <input type="checkbox"/> Centrifugal <input type="checkbox"/> Other	
			20. Water well contractor's certification:	This well was drilled under my jurisdiction and this report is true to the best of my knowledge and belief. Weishaar Drilling 232 Business name License No. Address Scott City, KS 67871 Signed  Authorized representative 7-19-76 Date	