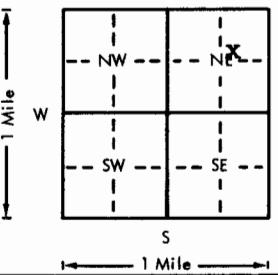
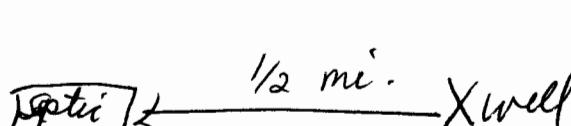


USE TYPEWRITER OR BALL
POINT PEN-PRESS FIRMLY,
PRINT CLEARLY.

WATER WELL RECORD
KSA 82a-1201-1215

Kansas Department of Health and
Environment-Division of Environment
(Water well Contractors)
Topeka, Kansas 66620

1. Location of well:	County	Fraction	Section number	Township number	Range number
	Wichita	SW 1/4 NE 1/4 NE 1/4	4	T 18	S R 38 E (W)
2. Distance and direction from nearest town or city:	3N, 3/4E, 1/2S of		3. Owner of well:	Frank Whitham	
Street address of well location if in city:	Selkirk, KS		R.R. or street:	Box Q	
4. Locate with "X" in section below:	Sketch map:		6. Bore hole dia.	in. Completion date	
				124	Well depth 194 ft. 2-18-75
			7. <input type="checkbox"/> Cable tool <input type="checkbox"/> Rotary <input type="checkbox"/> Driven <input type="checkbox"/> Dug <input type="checkbox"/> Hollow rod <input type="checkbox"/> Jetted <input type="checkbox"/> Bored <input checked="" type="checkbox"/> Reverse rotary		
5. Type and color of material	From	To	8. Use: <input type="checkbox"/> Domestic <input type="checkbox"/> Public supply <input type="checkbox"/> Industry <input checked="" type="checkbox"/> Irrigation <input type="checkbox"/> Air conditioning <input type="checkbox"/> Stock <input type="checkbox"/> Lawn <input type="checkbox"/> Oil field water <input type="checkbox"/> Other		
Clay	0	21	9. Casing: Material <input checked="" type="checkbox"/> Steel Height: <input type="checkbox"/> above or below Threaded <input type="checkbox"/> Welded <input checked="" type="checkbox"/> Surface 10 in. RMP <input type="checkbox"/> PVC <input type="checkbox"/> Weight 217.5 lbs./ft.		
Gyp	21	39	Dia. 12 in. to 194 ft. depth Wall Thickness: inches or Dia. <input type="checkbox"/> in. to <input type="checkbox"/> ft. depth gage No. 134		
Clay	39	69	10. Screen: Manufacturer's name <input checked="" type="checkbox"/> Free Flow		
Fine sd clay	69	78	Type <input checked="" type="checkbox"/> Prime Steel Dia. 12 in. <input checked="" type="checkbox"/> clay/gauze .179 Length 40 ft.		
Sd rock	78	83	Set between 154 ft. and 194 ft. ft. and <input type="checkbox"/> ft.		
Fine sd clay	83	91	Gravel pack? <input checked="" type="checkbox"/> yes Size range of material 3/4- <input type="checkbox"/>		
Sd rock	91	93	11. Static water level: mo./day/yr. 130 ft. below land surface Date 11-29-74		
Clay	93	112	12. Pumping level below land surfaces: 150 ft. after 4 hrs. pumping 450 g.p.m. 160 ft. after 4 hrs. pumping 550 g.p.m. Estimated maximum yield 550 g.p.m.		
Fine sd clay	112	119	13. Water sample submitted: mo./day/yr. Yes <input checked="" type="checkbox"/> No <input type="checkbox"/> Date		
Sd rock H	119	125	14. Well head completion: <input type="checkbox"/> Pitless adapter <input checked="" type="checkbox"/> 12 Inches above grade		
Fine sd clay	125	139	15. Well grouted? <input checked="" type="checkbox"/> With: <input type="checkbox"/> Neat cement <input type="checkbox"/> Bentonite <input checked="" type="checkbox"/> Concrete Depth: From <input type="checkbox"/> ft. to 15 ft.		
Sd med	139	142	16. Nearest source of possible contamination: ft. 2640 Direction W Type <input checked="" type="checkbox"/> Septic		
Fine sd clay	142	147	Well disinfected upon completion? <input checked="" type="checkbox"/> Yes <input type="checkbox"/> No		
Sd med good	147	164	17. Pump: Manufacturer's name <input checked="" type="checkbox"/> Simmons Model number GE HP 40 Volts 460 Length of drop pipe 180 ft. capacity 550 g.p.m.		
Clay	164	171	Type: <input type="checkbox"/> Submersible <input checked="" type="checkbox"/> Turbine <input type="checkbox"/> Jet <input type="checkbox"/> Reciprocating <input type="checkbox"/> Centrifugal <input type="checkbox"/> Other		
Sd coarse	171	183	18. Elevation: Topography: <input type="checkbox"/> Hill <input type="checkbox"/> Slope <input checked="" type="checkbox"/> Upland <input type="checkbox"/> Valley	19. Remarks: Clay 183 187 Sd coarse 187 188 Clay 188 200 Yellow 200 202 Shale 202 205	20. Water well contractor's certification: This well was drilled under my jurisdiction and this report is true to the best of my knowledge and belief. Weishaar Drilling 232 Business name <input type="checkbox"/> Scott City, KS 67871 License No. Address <input type="checkbox"/> Signed <input type="checkbox"/> Authorized representative 7-19-76 Date

Forward the white, blue and pink copies to the Department of Health and Environment

Form WWC-5