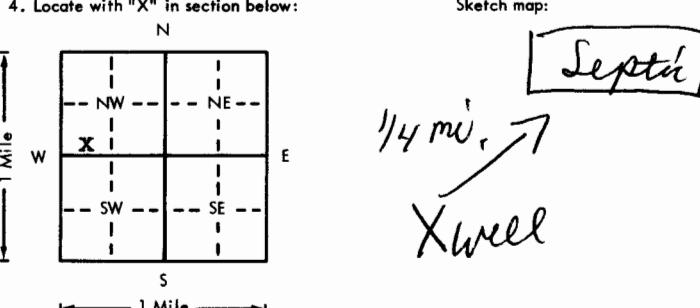


USE TYPEWRITER OR BALL
POINT PEN-PRESS FIRMLY,
PRINT CLEARLY.

WATER WELL RECORD
KSA 82a-1201-1215

Kansas Department of Health and
Environment-Division of Environment
(Water well Contractors)
Topeka, Kansas 66620

1. Location of well:	County Wichita	Fraction SW 1/4 SW 1/4 NW 1/4	Section number 4	Township number T 18 S	Range number R 38 E
2. Distance and direction from nearest town or city:	2 1/2 N, 1/4 E of Selkirk, KS		3. Owner of well: Frank Whitham		
Street address of well location if in city:			R.R. or street: Box Q		
City, state, zip code:			Leoti, KS 67861		
4. Locate with "X" in section below:	Sketch map: 		6. Bore hole dia. 26 in. Completion date 2-1-75	Well depth 206 ft.	
	N	E	7. <input type="checkbox"/> Cable tool <input type="checkbox"/> Rotary <input type="checkbox"/> Driven <input type="checkbox"/> Dug <input type="checkbox"/> Hollow rod <input type="checkbox"/> Jetted <input type="checkbox"/> Bored <input checked="" type="checkbox"/> Reverse rotary		
	W	S	8. Use: <input type="checkbox"/> Domestic <input type="checkbox"/> Public supply <input type="checkbox"/> Industry <input checked="" type="checkbox"/> Irrigation <input type="checkbox"/> Air conditioning <input type="checkbox"/> Stock <input type="checkbox"/> Lawn <input type="checkbox"/> Oil field water <input type="checkbox"/> Other		
	1 Mile	1 Mile	9. Casing: Material Steel Height: Above or below Threaded <input type="checkbox"/> Welded <input checked="" type="checkbox"/> Surface 10 in. RMP <input type="checkbox"/> PVC <input type="checkbox"/> Weight 31.67 lbs./ft. Dia. 16 in. to 206 ft. depth Wall Thickness: inches or Dia. <input type="checkbox"/> in. to <input type="checkbox"/> ft. depth gage No. 188		
5. Type and color of material	From	To	10. Screen: Manufacturer's name Johnson & Free Flow Galv. & prime Type steel Dia. 16 in. .100 & .125 in. dia/gauge Length 40 ft. Set between 166 ft. and 206 ft. Gravel pack? yes Size range of material 3/4 - 1		
Clay	0	23	11. Static water level: 130 ft. below land surface Date 11/7/74		
Gyp	23	52	12. Pumping level below land surfaces: 164 ft. after 4 hrs. pumping 250 g.p.m. 188 ft. after 4 hrs. pumping 410 g.p.m. Estimated maximum yield 410 g.p.m.		
Clay	52	67	13. Water sample submitted: Yes <input checked="" type="checkbox"/> No <input type="checkbox"/> Date <input type="checkbox"/>		
Sd coarse	67	85	14. Well head completion: Pitless adapter 12 Inches above grade		
Clay	85	100	15. Well grouted? <input checked="" type="checkbox"/>		
Sd coarse	100	108	With: <input type="checkbox"/> Neat cement <input type="checkbox"/> Bentonite <input checked="" type="checkbox"/> Concrete Depth: From 0 ft. to 15 ft.		
Fine sd clay	108	147	16. Nearest source of possible contamination: ft. 1320 Direction NE Type Septic Well disinfected upon completion? <input checked="" type="checkbox"/> Yes <input type="checkbox"/> No		
Sd coarse	147	154	17. Pump: <input type="checkbox"/> Not installed Manufacturer's name Simmons Model number US HP 30 Volts 460 Length of drop pipe 195 ft. capacity 410 g.p.m.		
Fine sd clay	154	165	Type: <input type="checkbox"/> Submersible <input checked="" type="checkbox"/> Turbine <input type="checkbox"/> Jet <input type="checkbox"/> Reciprocating <input type="checkbox"/> Centrifugal <input type="checkbox"/> Other		
Fine sd	165	172	18. Elevation:	19. Remarks:	20. Water well contractor's certification: This well was drilled under my jurisdiction and this report is true to the best of my knowledge and belief. Weishaar Drilling 232 Business name <input type="checkbox"/> Address Scotts Bluff, KS 67871 License No. <input type="checkbox"/> Signed <input type="checkbox"/> Authorized representative 7-19-76 Date <input type="checkbox"/>
Topography: <input type="checkbox"/> Hill <input type="checkbox"/> Slope <input checked="" type="checkbox"/> Upland <input type="checkbox"/> Valley	(Use a second sheet if needed)				

Forward the white, blue and pink copies to the Department of Health and Environment

Form WWC-5