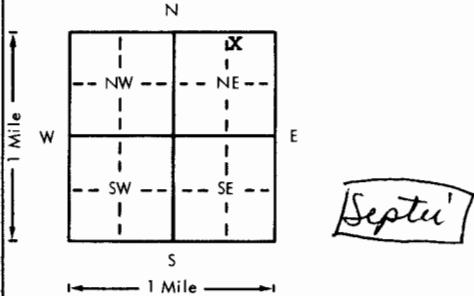


USE TYPEWRITER OR BALL
POINT PEN-PRESS FIRMLY,
PRINT CLEARLY.

WATER WELL RECORD
KSA 82a-1201-1215

Kansas Department of Health and
Environment-Division of Environment
(Water well Contractors)
Topeka, Kansas 66620

1. Location of well:	County Wichita	Fraction NW 1/4 NE 1/4 NE 1/4	Section number 4	Township number T 18	Range number S R 38 E N
2. Distance and direction from nearest town or city:	3N, 3/4E of Selkirk, KS	3. Owner of well: R.R. or street: City, state, zip code:	Frank Whitham Box 4 Leoti, KS 67861		
4. Locate with "X" in section below:	Sketch map: 			6. Bore hole dia. 26 in. Completion date 2-15-75 Well depth 194 ft.	
				7. <input type="checkbox"/> Cable tool <input type="checkbox"/> Rotary <input type="checkbox"/> Driven <input type="checkbox"/> Dug <input type="checkbox"/> Hollow rod <input type="checkbox"/> Jetted <input type="checkbox"/> Bored <input checked="" type="checkbox"/> Reverse rotary	
				8. Use: <input type="checkbox"/> Domestic <input type="checkbox"/> Public supply <input type="checkbox"/> Industry <input checked="" type="checkbox"/> Irrigation <input type="checkbox"/> Air conditioning <input type="checkbox"/> Stock <input type="checkbox"/> Lawn <input type="checkbox"/> Oil field water <input type="checkbox"/> Other	
				9. Casing: Material Steel Height: above or below Threaded <input type="checkbox"/> Welded <input checked="" type="checkbox"/> Surface 10 in. RMP <input type="checkbox"/> PVC Weight 31.67 lbs./ft. Dia. 16 in. to 194 ft. depth Wall Thickness: inches or Dia. <input type="checkbox"/> in. to <input type="checkbox"/> ft. depth gage No. 188	
5. Type and color of material	From	To	10. Screen: Manufacturer's name Johnson & Free Flow Type Steel Dia. 16 in. Slat gauze .100 & .125 Length 40 ft. Set between 154 ft. and 194 ft. Gravel pack? yes Size range of material 3/4-1		
Clay	0	18	11. Static water level: mo./day/yr. 138 ft. below land surface Date 11-18-74		
Rock H	18	19	12. Pumping level below land surfaces: 152 ft. after 4 hrs. pumping 380 g.p.m. 163 ft. after 4 hrs. pumping 600 g.p.m. Estimated maximum yield 600 g.p.m.		
Gyp	19	43	13. Water sample submitted: mo./day/yr. Yes <input checked="" type="checkbox"/> No Date		
Clay	43	82	14. Well head completion: Pitless adapter 12 inches above grade		
Fine sd clay	82	87	15. Well grouted? <input checked="" type="checkbox"/> With: Neat cement <input type="checkbox"/> Bentonite <input checked="" type="checkbox"/> Concrete Depth: From 0 ft. to 15 ft.		
Sd med	87	94	16. Nearest source of possible contamination: ft. 2640 Direction SW Type Septic Well disinfected upon completion? <input checked="" type="checkbox"/> Yes <input type="checkbox"/> No		
Fine sd clay	94	147	17. Pump: Not installed Manufacturer's name GE Simmons Model number GE HP 40 Volts 460 Length of drop pipe 180 ft. capacity 600 g.p.m. Type: <input type="checkbox"/> Submersible <input checked="" type="checkbox"/> Turbine <input type="checkbox"/> Jet <input type="checkbox"/> Reciprocating <input type="checkbox"/> Centrifugal <input type="checkbox"/> Other		
Sd coarse	147	179	18. Elevation: 18 ft. Topography: <input type="checkbox"/> Hill <input type="checkbox"/> Slope <input checked="" type="checkbox"/> Upland <input type="checkbox"/> Valley		
Clay	179	186	19. Remarks: (Use a second sheet if needed)		
Yellow	200	207	20. Water well contractor's certification: This well was drilled under my jurisdiction and this report is true to the best of my knowledge and belief. Weishaar Drilling 232 Business name Scott City, KS 67871 Address <input type="checkbox"/> Signed <input type="checkbox"/> Authorized representative 7-19-76 License No. Date		