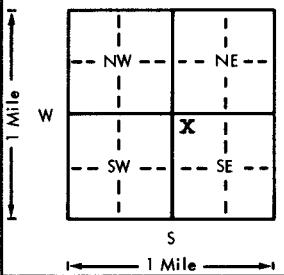
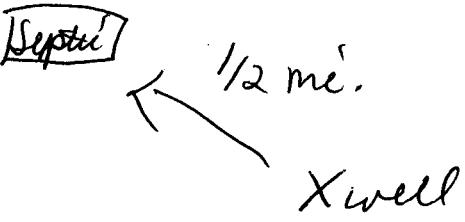


USE TYPEWRITER OR BALL
POINT PEN-PRESS FIRMLY,
PRINT CLEARLY.

WATER WELL RECORD
KSA 82a-1201-1215

Kansas Department of Health and
Environment-Division of Environment
(Water well Contractors)
Topeka, Kansas 66620

1. Location of well:	County	Fraction	Section number	Township number	Range number
	Wichita	NW 1/4 NW 1/4 SE 1/4	4	T 18 S	R 38 E
2. Distance and direction from nearest town or city:	3N, $\frac{1}{2}$ E, $\frac{1}{2}$ S of		3. Owner of well:	Frank Whitham	
Street address of well location if in city:	Selkirk, KS		R.R. or street:	Box Q	
4. Locate with "X" in section below:	Sketch map:		6. Bore hole dia. <u>26</u> in. Completion date <u>2-10-75</u> Well depth <u>205</u> ft.		
				7. <input type="checkbox"/> Cable tool <input type="checkbox"/> Rotary <input type="checkbox"/> Driven <input type="checkbox"/> Dug <input type="checkbox"/> Hollow rod <input type="checkbox"/> Jetted <input type="checkbox"/> Bored <input checked="" type="checkbox"/> Reverse rotary	
5. Type and color of material	From	To	8. Use: <input type="checkbox"/> Domestic <input type="checkbox"/> Public supply <input type="checkbox"/> Industry <input checked="" type="checkbox"/> Irrigation <input type="checkbox"/> Air conditioning <input type="checkbox"/> Stock <input type="checkbox"/> Lawn <input type="checkbox"/> Oil field water <input type="checkbox"/> Other		
Clay	0	17	9. Casing: Material <u>Steel</u> Height: <u>Above</u> or <u>below</u> Threaded <input type="checkbox"/> Welded <input checked="" type="checkbox"/> Surface <u>10</u> in. RMP <input type="checkbox"/> PVC <input type="checkbox"/> Weight <u>31.67</u> lbs./ft.		
Gyp	17	33	Dia. <u>16</u> in. to <u>205</u> ft. depth Wall Thickness: inches or Dia. <input type="checkbox"/> in. to <input type="checkbox"/> ft. depth gage No. <u>188</u>		
Rock H	33	36	10. Screen: Manufacturer's name <u>Johnson</u> <u>Calv. & Prime</u> & <u>Free Flow</u> Type <u>Steel</u> Dia. <u>16</u> in. <u>Silk gauze</u> <u>100&.125</u> Length <u>40</u> ft. Set between <u>165</u> ft. and <u>205</u> ft. ft. and <u>165</u> ft. Gravel pack? <u>yes</u> Size range of material <u>3/4-1</u>		
Gyp	36	52			
Clay	52	88			
Fine sd clay	88	97			
Clay	97	105			
Fine sd clay	105	112			
Sd rock	112	117			
Fine sd clay	117	137			
Sd coarse	137	157			
Clay	157	168			
Sd coarse	168	179			
Clay	189	185			
Sd coarse	185	188			
Clay	188	195			
18. Elevation:	19. Remarks:	(Use a second sheet if needed)			
Topography:	Sd coarse Clay yellow Shale	195 203 210	203 210	203 210	203 210
<input type="checkbox"/> Hill <input type="checkbox"/> Slope <input checked="" type="checkbox"/> Upland <input type="checkbox"/> Valley					
20. Water well contractor's certification: This well was drilled under my jurisdiction and this report is true to the best of my knowledge and belief.	Weishaar Drilling 232 Business name Scott City, KS 67871 Address Signature Authorized representative 7-19-76 Date				

Forward the white, blue and pink copies to the Department of Health and Environment

Form WWC-5