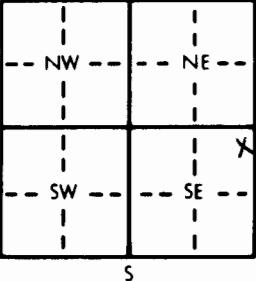
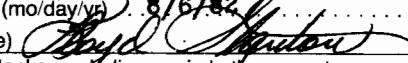


WATER WELL RECORD Form WWC-5 KSA 82a-1212

1 LOCATION OF WATER WELL:		Fraction County: Wichita	NE $\frac{1}{4}$ NE $\frac{1}{4}$ SE $\frac{1}{4}$	Section Number 8	Township Number T 18 S	Range Number R 38 E	
Distance and direction from nearest town or city street address of well if located within city? 2 miles North $\frac{1}{2}$ mile East of Selkirk, Kansas							
2 WATER WELL OWNER:		Jim Hahn RFD		Board of Agriculture, Division of Water Resources Application Number:			
RR#, St. Address, Box #:		1001, Kansas 67861					
3 LOCATE WELL'S LOCATION WITH AN "X" IN SECTION BOX:				4 DEPTH OF COMPLETED WELL 175 ft. ELEVATION: Depth(s) Groundwater Encountered 1. 128 ft. 2. ft. 3. ft. WELL'S STATIC WATER LEVEL 128 ft. below land surface measured on mo/day/yr Pump test data: Well water was ft. after hours pumping gpm Est. Yield gpm: Well water was ft. after hours pumping gpm Bore Hole Diameter 9 in. to 175 ft. and in. to ft. WELL WATER TO BE USED AS: 5 Public water supply 8 Air conditioning 11 Injection well 1 Domestic 3 Feedlot 6 Oil field water supply 9 Dewatering 12 Other (Specify below) 2 Irrigation 4 Industrial 7 Lawn and garden only 10 Observation well Was a chemical/bacteriological sample submitted to Department? Yes No X If yes, mo/day/yr sample was submitted Water Well Disinfected? Yes X No			
5 TYPE OF BLANK CASING USED:		5 Wrought iron 1 Steel 2 PVC	8 Concrete tile 6 Asbestos-Cement 7 Fiberglass	CASING JOINTS Glued Clamped Welded Threaded			
Blank casing diameter 5 in. to 155 ft., Dia in. to ft., Dia in. to ft.		Casing height above land surface 12 in., weight 2.368 lbs./ft. Wall thickness or gauge No. 214					
TYPE OF SCREEN OR PERFORATION MATERIAL:							
1 Steel 2 Brass		3 Stainless steel 4 Galvanized steel	5 Fiberglass 6 Concrete tile	7 PVC 8 RMP (SR) 9 ABS	10 Asbestos-cement 11 Other (specify) 12 None used (open hole)	10 Asbestos-cement 11 Other (specify) 12 None used (open hole)	
SCREEN OR PERFORATION OPENINGS ARE:		5 Gauzed wrapped 6 Wire wrapped 7 Torch cut					
1 Continuous slot 2 Louvered shutter		3 Mill slot 4 Key punched	8 Saw cut 9 Drilled holes 10 Other (specify)				
SCREEN-PERFORATED INTERVALS: From 155 ft.		to 175 ft., From ft. to ft.					
From		ft. to ft., From ft. to ft.					
GRAVEL PACK INTERVALS: From 120 ft.		to 175 ft., From ft. to ft.					
From		ft. to ft., From ft. to ft.					
6 GROUT MATERIAL: 1 Neat cement		2 Cement grout	3 Bentonite	4 Other	Drill cuttings		
Grout Intervals: From 15 ft. to 120 ft., From 4 ft. to 15 ft., From ft. to ft.							
What is the nearest source of possible contamination:							
1 Septic tank 2 Sewer lines 3 Watertight sewer lines		4 Lateral lines 5 Cess pool 6 Seepage pit	7 Pit privy 8 Sewage lagoon 9 Feedyard	10 Livestock pens 11 Fuel storage 12 Fertilizer storage 13 Insecticide storage	14 Abandoned water well 15 Oil well/Gas well 16 Other (specify below)		
Direction from well? Southeast							
How many feet? 100							
FROM	TO	LITHOLOGIC LOG		FROM	TO	LITHOLOGIC LOG	
0	14	Clay		14	21	Sand	
21	42	Clay		42	44	Rock	
44	49	Clay		49	52	Sand rock	
52	75	Clay		75	80	Fine sand	
80	85	Clay		85	125	Fine sand clay streaks	
125	149	Sand		149	154	Clay	
154	161	Sand		161	169	Clay	
169	173	Fine sand		173	175	Clay yellow	
175		Shale					
7 CONTRACTOR'S OR LANDOWNER'S CERTIFICATION: This water well was (1) constructed, (2) reconstructed, or (3) plugged under my jurisdiction and was completed on (mo/day/year) 8/4/82 and this record is true to the best of my knowledge and belief. Kansas Water Well Contractor's License No. 232 This Water Well Record was completed on (mo/day/yr) 8/6/82							
under the business name of Weishaar Drilling & Supply Inc. by (signature) 							
INSTRUCTIONS: Use typewriter or ball point pen, PLEASE PRESS FIRMLY and PRINT clearly. Please fill in blanks, underline or circle the correct answers. Send top three copies to Kansas Department of Health and Environment, Division of Environment, Environmental Geology Section, Topeka, KS 66620. Send one to WATER WELL OWNER and retain one for your records.							