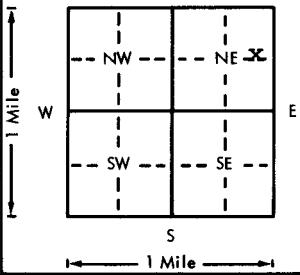


USE TYPEWRITER OR BALL  
POINT PEN-PRESS FIRMLY,  
PRINT CLEARLY.

WATER WELL RECORD  
KSA 82a-1201-1215

Kansas Department of Health and  
Environment-Division of Environment  
(Water well Contractors)  
Topeka, Kansas 66620

1. Location of well:	County	Fraction	Section number	Township number	Range number
	Wichita	SE 1/4 NE 1/4 NE 1/4	8	T 18	S R 38 E <b>W</b>
2. Distance and direction from nearest town or city:	2 miles N and 1 mile E of Selkirk, Kansas		3. Owner of well:	Bjurstrom Farms	
Street address or well location if in city:			City, state, zip code: Leoti, Kansas		
4. Locate with "X" in section below:	Sketch map:			6. Bore hole dia. <u>28</u> in. Completion date <u>4-23-76</u> Well depth <u>192</u> ft.	
 1049 <sup>1</sup> S of, NE corner of the NE <sup>1/4</sup> , Sec. 8, T18S, R38W, Wichita Co., Ks			7. <input type="checkbox"/> Cable tool <input type="checkbox"/> Rotary <input type="checkbox"/> Driven <input type="checkbox"/> Dug <input type="checkbox"/> Hollow rod <input type="checkbox"/> Jetted <input checked="" type="checkbox"/> Bored <input type="checkbox"/> Reverse rotary		
5. Type and color of material	From	To	8. Use: <input type="checkbox"/> Domestic <input type="checkbox"/> Public supply <input type="checkbox"/> Industry <input checked="" type="checkbox"/> Irrigation <input type="checkbox"/> Air conditioning <input type="checkbox"/> Stock <input type="checkbox"/> Lawn <input type="checkbox"/> Oil field water <input type="checkbox"/> Other		
Top soil	0	2	9. Casing: Material <u>STL</u> Height: Above or below Threaded <input type="checkbox"/> Welded <input checked="" type="checkbox"/> Surface <u>12</u> in. RMP <u>1000</u> PVC Weight <u>37</u> lbs./ft. Dia. <u>16</u> in. to <u>131</u> ft. depth, Wall thickness: inches or Dia. <u>16</u> in. to <u>131</u> ft. depth, Gauge No. <u>.219</u>		
Sandy Top soil	2	12	10. Screen: Manufacturer's name <u>Cook, Doerr, Layne and Foster</u> Louver WW and <u>1/2" Millislot</u> Dia. <u>16"</u> Slot/gauze <u>1/8"</u> Length <u>61 1/2</u> Set between <u>131</u> ft. and <u>192</u> ft. ft. and ft. Gravel pack? <input checked="" type="checkbox"/> Yes Size range of material <u>4.4mm</u>		
Limestone & tan clay streaks	12	41	11. Static water level: mo./day/yr. <u>12.5</u> ft. below land surface Date <u>10-21-75</u>		
Fine to coarse sand med. gravel with limestone streaks.	41	68	12. Pumping level below land surfaces: <u>170</u> ft. after <u>1</u> hrs. pumping <u>862</u> g.p.m. ft. after hrs. pumping g.p.m. Estimated maximum yield <u>1000</u> g.p.m.		
Tan clay with sand & gravel streaks	68	104	13. Water sample submitted: mo./day/yr. <input type="checkbox"/> Yes <input checked="" type="checkbox"/> No Date		
Fine to coarse sand	104	121	14. Well head completion: <input type="checkbox"/> Pitless adapter <input checked="" type="checkbox"/> Inches above grade		
Yellow clay	121	131	15. Well grouted? <input checked="" type="checkbox"/> Yes With: <input type="checkbox"/> Neat cement <input checked="" type="checkbox"/> Bentonite <input type="checkbox"/> Concrete Depth: From <u>0</u> ft. to <u>10</u> ft.		
Coarse sand med. to coarse gravel	131	163	16. Nearest source of possible contamination: Unk ft. Direction Type Well disinfected upon completion? <input checked="" type="checkbox"/> Yes <input type="checkbox"/> No		
Coarse sand med. to coarse gravel with lite tan clay streaks	163	178	17. Pump: <input type="checkbox"/> Not installed Manufacturer's name <u>Layne &amp; Bowler</u> Model number <u>12KL</u> HP <u>50</u> Volts Length of drop pipe <u>180</u> ft. capacity <u>700</u> g.p.m. Type: <input type="checkbox"/> Submersible <input checked="" type="checkbox"/> Turbine <input type="checkbox"/> Jet <input type="checkbox"/> Reciprocating <input type="checkbox"/> Centrifugal <input type="checkbox"/> Other		
Coarse sand med. gravel	178	192	18. Elevation:		
Yellow clay	192	198	19. Remarks: (Use a second sheet if needed)		
Black shale	198	200	20. Water well contractor's certification: This well was drilled under my jurisdiction and this report is true to the best of my knowledge and belief. <u>Layne - Western Co.</u> 150 Business name <u>Garden City, Kansas</u> License No. Address <u>Garden City, Kansas</u> Signed <u>J. L. Layne</u> Date <u>5-21-76</u> Authorized representative		