

WATER WELL RECORD

Form WWC-5

KSA 82a-1212


1 LOCATION OF WATER WELL:		Fraction County: Wichita	SW $\frac{1}{4}$ NW $\frac{1}{4}$ SW $\frac{1}{4}$	Section Number 15	Township Number T 18 S	Range Number R 38 E/W
---------------------------	--	-----------------------------	--	----------------------	---------------------------	--------------------------

Distance and direction from nearest town or city street address of well if located within city?

8 miles West $\frac{1}{4}$ North of Leoti, Kansas

2 WATER WELL OWNER:		Loy Oldham	Board of Agriculture, Division of Water Resources			
RR#, St. Address, Box #:		Leoti, Kansas 67861				Application Number:

3 LOCATE WELL'S LOCATION WITH AN "X" IN SECTION BOX:		4 DEPTH OF COMPLETED WELL... 125 ft. ELEVATION:			
--	--	---	--	--	--

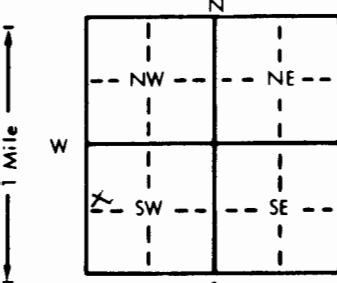

Depth(s) Groundwater Encountered 1. 82 ft. 2. ft. 3. ft.

WELL'S STATIC WATER LEVEL ... 82 ft. below land surface measured on mo/day/yr 4/7/82

NA Pump test data: Well water was ft. after hours pumping gpm

Est. Yield gpm: Well water was ft. after hours pumping gpm

Bore Hole Diameter 9 in. to 125 ft. and in. to ft.

WELL WATER TO BE USED AS: 5 Public water supply 8 Air conditioning 11 Injection well

1 Domestic 3 Feedlot 6 Oil field water supply 9 Dewatering 12 Other (Specify below)

2 Irrigation 4 Industrial 7 Lawn and garden only 10 Observation well

Was a chemical/bacteriological sample submitted to Department? Yes No X If yes, mo/day/yr sample was submitted

Water Well Disinfected? Yes X No

5 TYPE OF BLANK CASING USED:		5 Wrought iron	8 Concrete tile	CASING JOINTS	Glued	Clamped
------------------------------	--	----------------	-----------------	---------------	-------	---------

1 Steel	3 RMP (SR)	6 Asbestos-Cement	9 Other (specify below)	Welded
2 PVC	4 ABS	7 Fiberglass	Threaded

Blank casing diameter 5 in. to 105 ft., Dia in. to ft., Dia in. to ft.

Casing height above land surface 12 in., weight 2.368 lbs./ft. Wall thickness or gauge No. 214

TYPE OF SCREEN OR PERFORATION MATERIAL:

1 Steel	3 Stainless steel	5 Fiberglass	8 RMP (SR)	10 Asbestos-cement
2 Brass	4 Galvanized steel	6 Concrete tile	9 ABS	11 Other (specify)

SCREEN OR PERFORATION OPENINGS ARE:

1 Continuous slot	3 Mill slot	5 Gauzed wrapped	7 PVC	11 None (open hole)
2 Louvered shutter	4 Key punched	6 Wire wrapped	9 Drilled holes
.....	7 Torch cut	10 Other (specify)

SCREEN-PERFORATED INTERVALS: From 105 ft. to 125 ft., From ft. to ft. From ft. to ft.

GRAVEL PACK INTERVALS: From 80 ft. to 125 ft., From ft. to ft. From ft. to ft.

6 GROUT MATERIAL: 1 Neat cement 2 Cement grout 3 Bentonite 4 Other Drill cuttings

Grout Intervals: From 15 ft. to 80 ft., From 4 ft. to 15 ft., From ft. to ft.

What is the nearest source of possible contamination:


1 Septic tank	4 Lateral lines	7 Pit privy	10 Livestock pens	14 Abandoned water well
2 Sewer lines	5 Cess pool	8 Sewage lagoon	11 Fuel storage	15 Oil well/Gas well
3 Watertight sewer lines	6 Seepage pit	9 Feedyard	12 Fertilizer storage	16 Other (specify below)

Direction from well? Northeast How many feet? 120

FROM		TO		LITHOLOGIC LOG		FROM		TO		LITHOLOGIC LOG	
0	34	Clay		34		55		55		Fine sand	
55	60	Sand		60		65		65		Clay	
65	80	Fine sand		80		88		88		Sand medium	
88	95	Clay		95		98		98		Fine sand	
98	110	Clay		110		113		113		Sandy clay	
113	114	Rock		114		117		117		Clay	
117	121	Sand & gravel		121		125		125		Yellow clay	

7 CONTRACTOR'S OR LANDOWNER'S CERTIFICATION: This water well was 1) constructed, 2) reconstructed, or 3) plugged under my jurisdiction and was completed on (mo/day/year) 4/8/82 and this record is true to the best of my knowledge and belief. Kansas

Water Well Contractor's License No. 232 This Water Well Record was completed on (mo/day/yr) 4/13/82

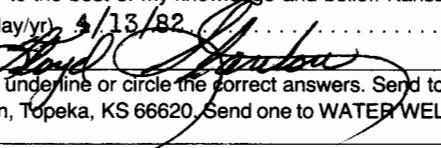under the business name of Weishaar Drilling & Supply Inc. by (signature) 

INSTRUCTIONS: Use typewriter or ball point pen, PLEASE PRESS FIRMLY and PRINT clearly. Please fill in blanks, underline or circle the correct answers. Send top three copies to Kansas Department of Health and Environment, Division of Environment, Environmental Geology Section, Topeka, KS 66620. Send one to WATER WELL OWNER and retain one for your records.