

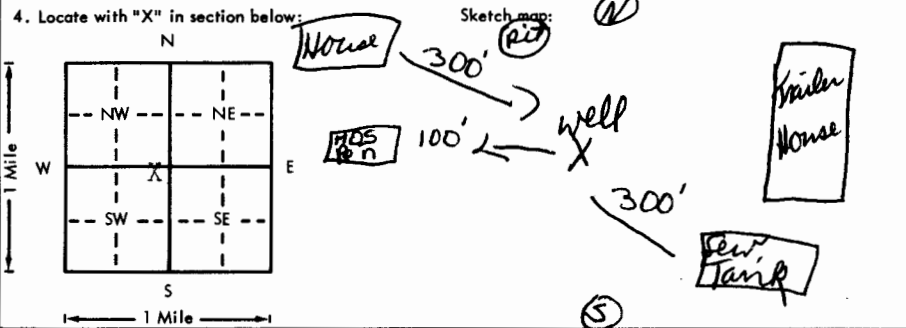
USE TYPEWRITER OR BALL
POINT PEN-PRESS FIRMLY,
PRINT CLEARLY.

SELKIRK

WATER WELL RECORD
KSA 82a-1201-1215

Kansas Department of Health and
Environment-Division of Environment
(Water well Contractors)
Topeka, Kansas 66620

CHA

1. Location of well:		County Wichita	Fraction NE 1/4 NE 1/4 SW 1/4	Section number 21	Township number T 18 S	Range number R 38 E
2. Distance and direction from nearest town or city: 1 E of Selkirk, KS				3. Owner of well: Wayne Marchy		
Street address of well location if in city:				R.R. or street: City, state, zip code: Leoti, KS 67861		
4. Locate with "X" in section below: 				6. Bore hole dia. 9 in. Completion date 10-3-75 Well depth 162 ft.		
5. Type and color of material				7. <input checked="" type="checkbox"/> Cable tool <input checked="" type="checkbox"/> Rotary <input type="checkbox"/> Driven <input type="checkbox"/> Dug <input type="checkbox"/> Hollow rod <input type="checkbox"/> Jetted <input type="checkbox"/> Bored <input type="checkbox"/> Reverse rotary		
				8. Use: <input checked="" type="checkbox"/> Domestic <input type="checkbox"/> Public supply <input type="checkbox"/> Industry <input type="checkbox"/> Irrigation <input type="checkbox"/> Air conditioning <input type="checkbox"/> Stock <input type="checkbox"/> Lawn <input type="checkbox"/> Oil field water <input type="checkbox"/> Other		
				9. Casing: Material Plas Height Above or below Threaded <input type="checkbox"/> Welded <input checked="" type="checkbox"/> Surface 12 in. RMP <input checked="" type="checkbox"/> PVC <input type="checkbox"/> Weight 1.8 lbs./ft. Dia. 5 in. to 142 ft. depth Wall Thickness: inches or Dia. <input type="checkbox"/> in. to <input type="checkbox"/> ft. depth gage No. 250		
				10. Screen: Manufacturer's name Jess & Lowell Type RMP Dia. 5 in. <input checked="" type="checkbox"/> Slot gauge 1/16 Length 20 ft. Set between 142 ft. and 162 ft. ft. and <input type="checkbox"/> ft. Gravel pack? Yes Size range of material 1/2-1/8		
				11. Static water level: <input type="checkbox"/> mo./day/yr. 113 ft. below land surface Date 10-3-75		
				12. Pumping level below land surfaces: 123 ft. after 1 hrs. pumping 18 g.p.m. <input type="checkbox"/> ft. after <input type="checkbox"/> hrs. pumping <input type="checkbox"/> g.p.m. Estimated maximum yield 18 g.p.m.		
				13. Water sample submitted: <input type="checkbox"/> mo./day/yr. <input type="checkbox"/> Yes <input checked="" type="checkbox"/> No Date <input type="checkbox"/>		
				14. Well head completion: <input checked="" type="checkbox"/> Pitless adapter <input type="checkbox"/> inches above grade		
				15. Well grouted? <input checked="" type="checkbox"/> With: <input checked="" type="checkbox"/> Neat cement <input type="checkbox"/> Bentonite <input type="checkbox"/> Concrete Depth: From 0 ft. to 15 ft.		
				16. Nearest source of possible contamination: Hog ft. 100 Direction E Type Pen Well disinfected upon completion? <input checked="" type="checkbox"/> Yes <input type="checkbox"/> No		
				17. Pump: <input type="checkbox"/> Not installed Manufacturer's name Red Jacket Model number 150T1 HP 1 1/2 Volts 230 Length of drop pipe 151 ft. capacity 18 g.p.m. Type: <input checked="" type="checkbox"/> Submersible <input type="checkbox"/> Turbine <input type="checkbox"/> Jet <input type="checkbox"/> Reciprocating <input type="checkbox"/> Centrifugal <input type="checkbox"/> Other		
18. Elevation:		19. Remarks:		20. Water well contractor's certification:		
		Clay		This well was drilled under my jurisdiction and this report is true to the best of my knowledge and belief.		
		Sd coarse		Weishaar Drilling 232		
		Clay yellow		Business name Leoti, Kansas License No. 67871		
		shale		Address Leoti, Kansas Date 11-20-75		
Topography: <input type="checkbox"/> Hill <input checked="" type="checkbox"/> Slope <input type="checkbox"/> Upland <input type="checkbox"/> Valley		BROCK 156'		Signed [Signature] Authorized representative		

Forward the white, blue and pink copies to the Department of Health and Environment

Form WWC-5